

**WATER WELL RECORD Form WWC-5**

Division of Water Resources App. No.


9665

Well ID

- Original Record
- Correction
- Change in Well Use

**1 LOCATION OF WATER WELL:** County: Gray  
 Fraction NW ¼ NE ¼ NE ¼ SE ¼ Section Number 11 Township Number T 26 S Range Number R 28  E  W

**2 WELL OWNER:** Last Name: Woods First: Phillip  
 Business: Address: PO Box 364 City: Cimarron State: KS ZIP: 67835  
 Street or Rural Address where well is located (if unknown, distance and direction from nearest town or intersection): Ave C & 4th Street, Cimarron, KS 100 yards west

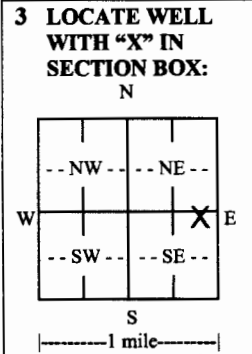

**4 DEPTH OF COMPLETED WELL:** 200 ft.  
 Depth(s) Groundwater Encountered: 1) 82 ft. 2) 82 ft. 3) 82 ft. 4) Dry Well  
 WELL'S STATIC WATER LEVEL: 82 ft.  
 below land surface, measured on (mo-day-yr) 04/08/2016  
 above land surface, measured on (mo-day-yr)  
 Pump test data: Well water was \_\_\_\_\_ ft. after \_\_\_\_\_ hours pumping \_\_\_\_\_ gpm  
 Well water was \_\_\_\_\_ ft. after \_\_\_\_\_ hours pumping \_\_\_\_\_ gpm  
 Estimated Yield: 500 gpm  
 Bore Hole Diameter: 26 in. to 200 ft. and \_\_\_\_\_ in. to \_\_\_\_\_ ft.

**5 Latitude:** 37.8024435 (decimal degrees)  
**Longitude:** 100.344198 (decimal degrees)  
 Datum:  WGS 84  NAD 83  NAD 27  
 Source for Latitude/Longitude:  
 GPS (unit make/model: \_\_\_\_\_) (WAAS enabled?  Yes  No)  
 Land Survey  Topographic Map  
 Online Mapper: \_\_\_\_\_

**6 Elevation:** 2611 ft.  Ground Level  TOC  
 Source:  Land Survey  GPS  Topographic Map  
 Other KOLAR

**7 WELL WATER TO BE USED AS:**

1. Domestic: <input type="checkbox"/> Household <input type="checkbox"/> Lawn & Garden <input type="checkbox"/> Livestock	5. <input type="checkbox"/> Public Water Supply: well ID _____	10. <input type="checkbox"/> Oil Field Water Supply: lease _____
2. <input checked="" type="checkbox"/> Irrigation	6. <input type="checkbox"/> Dewatering: how many wells? _____	11. Test Hole: well ID _____ <input type="checkbox"/> Cased <input type="checkbox"/> Uncased <input type="checkbox"/> Geotechnical
3. <input type="checkbox"/> Feedlot	7. <input type="checkbox"/> Aquifer Recharge: well ID _____	12. Geothermal: how many bores? _____ a) Closed Loop <input type="checkbox"/> Horizontal <input type="checkbox"/> Vertical
4. <input type="checkbox"/> Industrial	8. <input type="checkbox"/> Monitoring: well ID _____	b) Open Loop <input type="checkbox"/> Surface Discharge <input type="checkbox"/> Inj. of Water
	9. Environmental Remediation: well ID _____ <input type="checkbox"/> Air Sparge <input type="checkbox"/> Soil Vapor Extraction <input type="checkbox"/> Recovery <input type="checkbox"/> Injection	13. <input type="checkbox"/> Other (specify): _____

Was a chemical/bacteriological sample submitted to KDHE?  Yes  No If yes, date sample was submitted: \_\_\_\_\_  
 Water well disinfected?  Yes  No

**8 TYPE OF CASING USED:**  Steel  PVC  Other \_\_\_\_\_ CASING JOINTS:  Glued  Clamped  Welded  Threaded  
 Casing diameter 16 in. to 200 ft., Diameter \_\_\_\_\_ in. to \_\_\_\_\_ ft., Diameter \_\_\_\_\_ in. to \_\_\_\_\_ ft.  
 Casing height above land surface 12 in. Weight \_\_\_\_\_ lbs./ft. Wall thickness or gauge No. SCH 40  
 TYPE OF SCREEN OR PERFORATION MATERIAL:  
 Steel  Stainless Steel  Fiberglass  PVC  Other (Specify) \_\_\_\_\_  
 Brass  Galvanized Steel  Concrete tile  None used (open hole)  
 SCREEN OR PERFORATION OPENINGS ARE:  
 Continuous Slot  Mill Slot  Gauze Wrapped  Torch Cut  Drilled Holes  Other (Specify) \_\_\_\_\_  
 Louvered Shutter  Key Punched  Wire Wrapped  Saw Cut  None (Open Hole)  
 SCREEN-PERFORATED INTERVALS: From 100 ft. to 200 ft., From \_\_\_\_\_ ft. to \_\_\_\_\_ ft., From \_\_\_\_\_ ft. to \_\_\_\_\_ ft.  
 GRAVEL PACK INTERVALS: From 20 ft. to 200 ft., From \_\_\_\_\_ ft. to \_\_\_\_\_ ft., From \_\_\_\_\_ ft. to \_\_\_\_\_ ft.

**9 GROUT MATERIAL:**  Neat cement  Cement grout  Bentonite  Other \_\_\_\_\_  
 Grout Intervals: From 0 ft. to 20 ft., From \_\_\_\_\_ ft. to \_\_\_\_\_ ft., From \_\_\_\_\_ ft. to \_\_\_\_\_ ft.  
 Nearest source of possible contamination:  
 Septic Tank  Lateral Lines  Pit Privy  Livestock Pens  Insecticide Storage  
 Sewer Lines  Cess Pool  Sewage Lagoon  Fuel Storage  Abandoned Water Well  
 Watertight Sewer Lines  Seepage Pit  Feedyard  Fertilizer Storage  Oil Well/Gas Well  
 Other (Specify) \_\_\_\_\_  
 Direction from well? NW Distance from well? 20 ft.

10 FROM	TO	LITHOLOGIC LOG	FROM	TO	LITHO. LOG (cont.) or PLUGGING INTERVALS
Attached	Attached	Attached			

**11 CONTRACTOR'S OR LANDOWNER'S CERTIFICATION:** This water well was  constructed,  reconstructed, or  plugged under my jurisdiction and was completed on (mo-day-year) 04/08/2016 and this record is true to the best of my knowledge and belief. Kansas Water Well Contractor's License No. 846 This Water Well Record was completed on (mo-day-year) 04/12/2016 under the business name of Nash Water Well Service, LLC

Form	WWC5
Contractor	Nash Water Well Service, LLC
Well Owner	Phillip Woods
Doc ID	1293480

Litholgy

0	17	Top soil, Tan Gray Clay
17	35	Fine coarse sand w/small gravel streak
35	48	Clay w/fine tight sand streaks
48	70	Tan white clay w/soft white rock & calichie
70	80	Fine coarse sand w/small to medium gravel
80	85	Fine coarse sand
85	93	Tan clay
93	100	Fine coarse sand, small gravel
100	110	Tan clay
110	117	Fine coarse sand (loose)
117	130	Tan clay
130	146	Fine coarse sand w/tan clay streaks
146	150	Tan clay
150	165	Fine medium sand
165	169	Tan clay
169	172	Fine coarse sand w/small gravel
172	174	Clay
174	176	Fine coarse sand w/small gravel
176	179	Tan clay

Form	WWC5
Contractor	Nash Water Well Service, LLC
Well Owner	Phillip Woods
Doc ID	1293480

Litholgy

179	181	Hard rock
181	189	Tan clay
189	200	Blue shale