

County: Gray Fraction: NW NE NE SE Sec. 11 T. 26 S R. 28 E/W

**CORRECTION(S) to WATER WELL COMPLETION RECORD Form WWC-5 (to rectify lacking or incorrect information)**

Owner: Phillip Woods

If location corrected, was listed as:

Location changed to:

Section-Township-Range: \_\_\_\_\_

\_\_\_\_\_

Fraction (1/4 calls): \_\_\_\_\_

\_\_\_\_\_

Other changes: Initial statements: Total depth was reported as 70 ft

Changed to: 20 ft

Comments: \_\_\_\_\_

Verification method: contacted Nash Water Well service (Lic #846) and obtained correct information

Initials: PKC Date: 3/17/17

Submitted by:  Kansas Geological Survey, Data Resources Library, 1930 Constant Ave., Lawrence, KS 66047-3726  
 Kansas Dept. of Health & Environment, Bureau of Water, 1000 SW Jackson, Suite 420, Topeka, KS 66612-1367


**WATER WELL PLUGGING RECORD Form WWC-5P KSA 82a-1212 ID NO.**

1 **LOCATION OF WATER WELL:** Fraction NW 1/4 NE 1/4 NE 1/4 SE 1/4 Section Number 11 Township Number 26T S Range Number 28  E  W  
 County: Gray

Street/Rural Address of Well Location; if unknown, distance & direction from nearest town or intersection: If at owner's address, check here  Ave C & 4th Street, Cimarron, KS 100yds West

**Global Positioning Systems (GPS) information:**  
 Latitude: 37.802577 (in decimal degrees)  
 Longitude: 100.344293 (in decimal degrees)  
 Elevation: 2612  
 Datum:  WGS84,  NAD83,  NAD27  
**Collection Method:**  
 GPS unit (Make/Model: \_\_\_\_\_)  
 Digital Map/Photo,  Topographic Map,  Land Survey  
 Est. Accuracy:  < 3 m,  3-5 m,  5-15 m,  > 15 m

2 **WATER WELL OWNER:** Phillip Woods  
 RR#, St. Address, Box #: Box 364  
 City, State ZIP Code: Cimarron, KS 67835

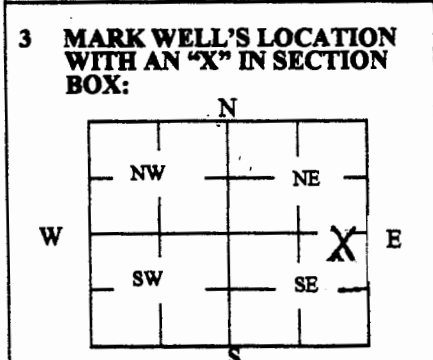

4 **DEPTH OF WELL** 70 ft.  
**WELL'S STATIC WATER LEVEL** 0 ft.  
**WELL WAS USED AS:**  
 Domestic  Public Water Supply  Dewatering  
 Irrigation  Oil Field Water Supply  Monitoring  
 Feedlot  Domestic (Lawn & Garden)  Injection Well  
 Industrial  Air Conditioning  Other \_\_\_\_\_  
 Was a chemical/bacteriological sample submitted to Department? Yes  No

5 **TYPE OF BLANK CASING USED:**  
 Steel  RMP (SR)  Wrought  Fiberglass  Other (Specify below)  
 PVC  ABS  Asbestos-Cement  Concrete Tile  
 Blank casing diameter 16 in. Was casing pulled? Yes  No  If yes, how much \_\_\_\_\_  
 Casing height above or below land surface 130 in.

6 **GROUT PLUG MATERIAL:**  Neat cement  Cement grout  Bentonite  Other \_\_\_\_\_  
 Grout Plug Intervals: From 20 ft. to 15 ft., From 5 ft. to 0 ft., From \_\_\_\_\_ ft. to \_\_\_\_\_ ft.  
 What is the nearest source of possible contamination:  
 Septic tank  Seepage pit  Fuel storage  Other (specify below)  
 Sewer lines  Pit privy  Fertilizer storage  
 Watertight sewer lines  Sewage lagoon  Insecticide storage  
 Lateral lines  Feedyard  Abandoned water well  Oil well/Gas well  
 Cess pool  Livestock pens  
 Direction from well? N  
 How many feet? 20'

FROM	TO	PLUGGING MATERIALS	FROM	TO	PLUGGING MATERIALS
0	4	Grout			
4	15	Clean fill sand			
15	20	Grout			

7 **CONTRACTOR'S OR LANDOWNER'S CERTIFICATION:** This water well was plugged under my jurisdiction and was completed on (mo/day/year) 5-3-16 and this record is true to the best of my knowledge and belief. Kansas Water Well Contractor's License No. 846. This Water Well Record was completed on (mo/day/year) 5-11-16 under the business name of Nash Water Well Service, LLC by (signature) Rebecca Wood

**INSTRUCTIONS:** Use typewriter or ballpoint pen. Please press firmly and print clearly. Please fill in blanks, underline or circle the correct answers. Send top three copies to Kansas Department of Health and Environment, Bureau of Water, Geology Section, 1000 SW Jackson St., Ste. 420, Topeka, Kansas 66612-1367. Telephone: 785/296-5524. Send one to Water Well Owner and retain one for your records. Visit us at <http://www.kdheks.gov/waterwell/index.html>.