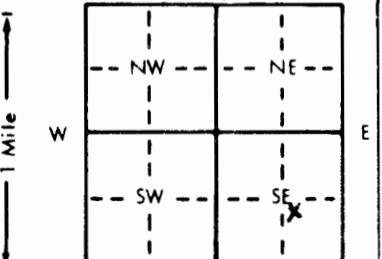


1 LOCATION OF WATER WELL:		Fraction		Section Number		Township Number		Range Number	
County: Gray		NW 1/4 SE 1/4 SE 1/4		23		T 26 S		R 28 EW	
Distance and direction from nearest town or city street address of well if located within city? From Cimarron, 2 miles south on 23 Hwy. then 1/2 mile west.									
2 WATER WELL OWNER: Gary Schadeqq									
RR#, St. Address, Box #: P.O. Box 616									
City, State, ZIP Code: Cimarron, KS. 67835									
Board of Agriculture, Division of Water Resources									
Application Number:									
3 LOCATE WELL'S LOCATION WITH AN "X" IN SECTION BOX:					4 DEPTH OF COMPLETED WELL: 190' ft. ELEVATION:				
					Depth(s) Groundwater Encountered 1. ft. 2. ft. 3. ft.				
					WELL'S STATIC WATER LEVEL 109' ft. below land surface measured on mo/day/yr 4-14-95				
					Pump test data: Well water was ft. after hours pumping gpm				
					Est. Yield gpm: Well water was ft. after hours pumping gpm				
					Bore Hole Diameter 978" in. to ft. and in. to ft.				
					WELL WATER TO BE USED AS:				
					1 Domestic 3 Feedlot 6 Oil field water supply 9 Dewatering 12 Other (Specify below)				
					2 Irrigation 4 Industrial 7 Lawn and garden only 10 Monitoring well				
					Was a chemical/bacteriological sample submitted to Department? Yes No X If yes, mo/day/yr sample was submitted				
					Water Well Disinfected? Yes X No				
5 TYPE OF BLANK CASING USED:									
1 Steel 3 RMP (SR) 5 Wrought iron 8 Concrete tile CASING JOINTS: Glued X Clamped									
2 PVC 4 ABS 6 Asbestos-Cement 9 Other (specify below) Welded									
7 Fiberglass Threaded									
Blank casing diameter 5" in. to 150' ft. Dia in. to ft. Dia in. to ft.									
Casing height above land surface 12" in. weight lbs./ft. Wall thickness or gauge No. SDR-21									
TYPE OF SCREEN OR PERFORATION MATERIAL:									
1 Steel 3 Stainless steel 5 Fiberglass 8 RMP (SR) 10 Asbestos-cement									
2 Brass 4 Galvanized steel 6 Concrete tile 9 ABS 11 Other (specify)									
12 None used (open hole)									
SCREEN OR PERFORATION OPENINGS ARE:									
1 Continuous slot 3 Mill slot 5 Gauzed wrapped 8 Saw cut 11 None (open hole)									
2 Louvered shutter 4 Key punched 6 Wire wrapped 9 Drilled holes									
7 Torch cut 10 Other (specify)									
SCREEN-PERFORATED INTERVALS: From 150' ft. to 190' ft. From ft. to ft. From ft. to ft.									
GRAVEL PACK INTERVALS: From 24' ft. to 138' ft. From 143' ft. to 190' ft.									
6 GROUT MATERIAL:									
1 Neat cement 2 Cement grout 3 Bentonite 4 Other									
Grout Intervals: From 4' ft. to 24' ft. From 138' ft. to 143' ft. From ft. to ft.									
What is the nearest source of possible contamination:									
1 Septic tank 4 Lateral lines 7 Pit privy 10 Livestock pens 14 Abandoned water well									
2 Sewer lines 5 Cess pool 8 Sewage lagoon 11 Fuel storage 15 Oil well/Gas well									
3 Watertight sewer lines 6 Seepage pit 9 Feedyard 12 Fertilizer storage 16 Other (specify below)									
13 Insecticide storage									
Direction from well? North How many feet? 6'									
FROM TO LITHOLOGIC LOG FROM TO PLUGGING INTERVALS									
0 1 Sandy Topsoil									
1 140 Med. Sand									
140 141 White clay									
141 160 med. sand									
160 190 Brown clay & med. sand									
190 198 Yellow clay & shale									
7 CONTRACTOR'S OR LANDOWNER'S CERTIFICATION: This water well was (1) constructed, (2) reconstructed, or (3) plugged under my jurisdiction and was completed on (mo/day/year) 4-14-95 and this record is true to the best of my knowledge and belief. Kansas									
Water Well Contractor's License No. 533 This Water Well Record was completed on (mo/day/yr) 5-5-95									
under the business name of Santzen Water Well Repair by (signature)									
INSTRUCTIONS: Use typewriter or ball point pen. PLEASE PRESS FIRMLY and PRINT clearly. Please fill in blanks, underline or circle the correct answers. Send top three copies to Kansas Department of Health and Environment, Bureau of Water, Topeka, Kansas 66620-0001. Telephone: 913-296-5545. Send one to WATER WELL OWNER and retain one for your records.									