

## WATER WELL RECORD

Form WWC-5

KSA 82a-1212

1 LOCATION OF WATER WELL:	Fraction	Section Number	Township Number	Range Number
County: <b>GRAY</b>	<b>SW 1/4</b>	<b>1</b>	<b>T 26 S</b>	<b>R 29 E/W</b>

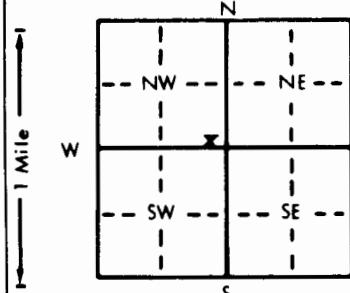
Distance and direction from nearest town or city street address of well if located within city?

**1/2 MILE EAST OF INGALLS SOUTHSIDE OF RR 150 FT SOUTH**

## 2 WATER WELL OWNER:

**FRANCIS GODDARD**  
**INGALLS, KS. 67853**Board of Agriculture, Division of Water Resources  
Application Number:

## 3 LOCATE WELL'S LOCATION WITH AN "X" IN SECTION BOX:

4 DEPTH OF COMPLETED WELL **172** ft. ELEVATION: .....

Depth(s) Groundwater Encountered 1. .... ft. 2. .... ft. 3. .... ft.

WELL'S STATIC WATER LEVEL **38** ft. below land surface measured on mo/day/yr **6/18/92** .....

Pump test data: Well water was ..... ft. after ..... hours pumping ..... gpm

Est. Yield ..... gpm: Well water was ..... ft. after ..... hours pumping ..... gpm

Bore Hole Diameter **9.78** in. to **177** ft. and ..... in. to ..... ft.

WELL WATER TO BE USED AS: 5 Public water supply 8 Air conditioning 11 Injection well

1 Domestic 3 Feedlot 6 Oil field water supply 9 Dewatering 12 Other (Specify below)

2 Irrigation 4 Industrial 7 Lawn and garden only 10 Monitoring well **WINDMILL** .....Was a chemical/bacteriological sample submitted to Department? Yes  No  If yes, mo/day/yr sample was submittedWater Well Disinfected? Yes  No

## 5 TYPE OF BLANK CASING USED:

5 Wrought iron 8 Concrete tile CASING JOINTS: Glued  Clamped .....

1 Steel 3 RMP (SR)

6 Asbestos-Cement 9 Other (specify below)

Welded .....

X 2 PVC 4 ABS

7 Fiberglass

Threaded .....

Blank casing diameter **5** in. to **152** ft. Dia ..... in. to ..... ft. Dia ..... in. to ..... ft.Casing height above land surface **18** in., weight ..... **200** lbs./ft. Wall thickness or gauge No. **200** .....

## TYPE OF SCREEN OR PERFORATION MATERIAL:

X 7 PVC 10 Asbestos-cement

1 Steel 3 Stainless steel

5 Fiberglass

8 RMP (SR)

11 Other (specify) .....

2 Brass 4 Galvanized steel

6 Concrete tile

9 ABS

12 None used (open hole) .....

## SCREEN OR PERFORATION OPENINGS ARE:

5 Gauzed wrapped

8 Saw cut

11 None (open hole) .....

1 Continuous slot 3 Mill slot

6 Wire wrapped

9 Drilled holes

2 Louvered shutter 4 Key punched

7 Torch cut

10 Other (specify) .....

SCREEN-PERFORATED INTERVALS: From. .... **153** ft. to ..... ft. From ..... ft. to ..... ft.From. .... **172** ft. to ..... ft. From ..... ft. to ..... ft.From. .... **172** ft. to ..... ft. From ..... ft. to ..... ft.GRAVEL PACK INTERVALS: From. .... **38** ft. to ..... **172** ft. From ..... ft. to ..... ft.

From ..... ft. to ..... ft. From ..... ft. to ..... ft.

6 GROUT MATERIAL: 1 Neat cement 2 Cement grout 3 Bentonite 4 Other .....

Grout Intervals: From. .... **0** ft. to ..... **38** ft. From ..... ft. to ..... ft. From ..... ft. to ..... ft.

What is the nearest source of possible contamination:

10 Livestock pens

14 Abandoned water well

1 Septic tank 4 Lateral lines

11 Fuel storage

15 Oil well/Gas well

2 Sewer lines 5 Cess pool

12 Fertilizer storage

16 Other (specify below) .....

3 Watertight sewer lines 6 Seepage pit

13 Insecticide storage .....

Direction from well?

How many feet? **50**

FROM TO LITHOLOGIC LOG FROM TO PLUGGING INTERVALS

<b>0</b>	<b>6</b>	<b>TOP SOIL</b>			
<b>6</b>	<b>12</b>	<b>BROWN SANDY CLAY</b>			
<b>12</b>	<b>17</b>	<b>FINE TO MED SAND AND GRAVEL (LOOSE)</b>			
<b>17</b>	<b>20</b>	<b>BROWN SANDY CLAY</b>			
<b>20</b>	<b>30</b>	<b>FINE TO MED SAND AND GRAVEL (LOOSE)</b>			
<b>30</b>	<b>33</b>	<b>ROCK (HARD)</b>			
<b>33</b>	<b>40</b>	<b>FINE TO MED SAND AND GRAVEL (LHARD ST ROCK)</b>			
<b>\$40</b>	<b>50</b>	<b>BROWN SANDY CLAY</b>			
<b>50</b>	<b>70</b>	<b>FINE TO MED SAND AND GRAVEL (LLOOSE)</b>			
<b>70</b>	<b>72</b>	<b>ROCK HARD</b>			
<b>72</b>	<b>86</b>	<b>BROWN SANDY CLAY</b>			
<b>86</b>	<b>90</b>	<b>FINE TO MED SAND AND GRAVEL (LOOSE)</b>			
<b>90</b>	<b>137</b>	<b>BROWN CLAY (LSTICKY)</b>			
<b>137</b>	<b>173</b>	<b>FINE TO MED SAND AND GRAVEL (LOOSE) MICAED WITH BROWN ROCK</b>			
<b>1873</b>	<b>177</b>	<b>YELLOW CLAY (HARD ROCK)</b>			

7 CONTRACTOR'S OR LANDOWNER'S CERTIFICATION: This water well was  constructed, (2) reconstructed, or (3) plugged under my jurisdiction and was completed on (mo/day/year) **6/20/92** ..... and this record is true to the best of my knowledge and belief. KansasWater Well Contractor's License No. **172** ..... This Water Well Record was completed on (mo/day/yr) **6/25/92** .....under the business name of **JONAGAN DRILLING CO.** by (signature) 

INSTRUCTIONS: Use typewriter or ball point pen. PLEASE PRESS FIRMLY and PRINT clearly. Please fill in blanks, underline or circle the correct answers. Send top three copies to Kansas Department of Health and Environment, Bureau of Water, Topeka, Kansas 6620-7320. Telephone: 913-296-5545. Send one to WATER WELL OWNER and retain one for your records.