

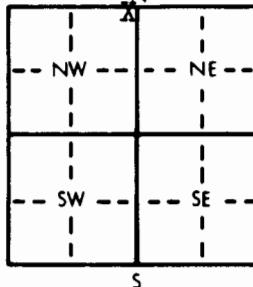
WATER WELL RECORD Form WWC-5 KSA 82a-1212

1 LOCATION OF WATER WELL:	Fraction County: Gray	NE 1/4	NE 1/4	NW 1/4	Section Number 22	Township Number T 26 S	Range Number R 29W E/W
---------------------------	---------------------------------	-----------	-----------	-----------	----------------------	---------------------------	---------------------------

Distance and direction from nearest town or city street address of well if located within city?

3 S, $\frac{1}{2}$ W of Ingalls, Kansas

2 WATER WELL OWNER:	Union Drilling Company 422 Union Center Wichita, Kansas 67202				Board of Agriculture, Division of Water Resources Unknown Application Number:		
---------------------	--	--	--	--	---	--	--

3 LOCATE WELL'S LOCATION WITH AN "X" IN SECTION BOX:					4 DEPTH OF COMPLETED WELL..... 206 ft. ELEVATION: Unknown		
--	--	--	--	--	---	--	--

Depth(s) Groundwater Encountered 1. **90** ft. 2. **90** ft. 3. **5/1/81** ft.WELL'S STATIC WATER LEVEL **90** ft. below land surface measured on mo/day/yr

Pump test data: Well water was ft. after hours pumping gpm

Est. Yield **60** gpm: Well water was ft. after hours pumping gpmBore Hole Diameter **8** in. to **206** ft., and in. to ft.

WELL WATER TO BE USED AS: 5 Public water supply 8 Air conditioning 11 Injection well

1 Domestic 3 Feedlot 6 Oil field water supply 9 Dewatering 12 Other (Specify below)

2 Irrigation 4 Industrial 7 Lawn and garden only 10 Observation well

Was a chemical/bacteriological sample submitted to Department? Yes **No**; If yes, mo/day/yr sample was submittedWater Well Disinfected? Yes **No**

5 TYPE OF BLANK CASING USED:	5 Wrought iron	8 Concrete tile	CASING JOINTS: <u>Glued</u>	Clamped
------------------------------	----------------	-----------------	-----------------------------------	---------------

1 Steel 3 RMP (SR) 6 Asbestos-Cement 9 Other (specify below) Welded

2 PVC 4 ABS 7 Fiberglass

Blank casing diameter **5** in. to **186** ft., Dia. in. to ft., Dia. in. to ft.Casing height above land surface **12** in., weight **2.8** lbs./ft. Wall thickness or gauge No. **Sch. 40**

TYPE OF SCREEN OR PERFORATION MATERIAL:	7 PVC	10 Asbestos-cement
---	-------	--------------------

1 Steel 3 Stainless steel 5 Fiberglass 8 RMP (SR) 11 Other (specify)

2 Brass 4 Galvanized steel 6 Concrete tile 9 ABS 12 None used (open hole)

SCREEN OR PERFORATION OPENINGS ARE:	5 Gauzed wrapped	8 <u>Saw cut</u>	11 None (open hole)
-------------------------------------	------------------	------------------	---------------------

1 Continuous slot 3 Mill slot 6 Wire wrapped 9 Drilled holes

2 Louvered shutter 4 Key punched 7 Torch cut 10 Other (specify)

SCREEN-PERFORATED INTERVALS: From 186 ft. to 206 ft., From	ft. to
--	--------------

From
 ft. to | ft. to | ft. to |

GRAVEL PACK INTERVALS: From 10 ft. to 206 ft., From	ft. to
---	--------------

From
 ft. to | ft. to | ft. to |

6 GROUT MATERIAL: 1 Neat cement 2 Cement grout 3 <u>Bentonite</u> 4 Other	10 Livestock pens	14 Abandoned water well
---	-------------------	-------------------------

Grout Intervals: From **0** ft. to **10** ft., From
 ft. to | ft. to |

What is the nearest source of possible contamination:

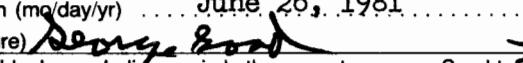
1 Septic tank 4 Lateral lines 7 Pit privy 11 Fuel storage 15 Oil well/Gas well

2 Sewer lines 5 Cess pool 8 Sewage lagoon 12 Fertilizer storage 16 Other (specify below)

3 Watertight sewer lines 6 Seepage pit 9 Feedyard 13 Insecticide storage

Direction from well? **West** How many feet? **60'**

FROM	TO	LITHOLOGIC LOG	FROM	TO	LITHOLOGIC LOG
------	----	----------------	------	----	----------------

0 105 **Sand and Gravel**105 168 **Clay**168 206 **Gravel**7 CONTRACTOR'S OR LANDOWNER'S CERTIFICATION: This water well was (1) constructed, (2) reconstructed, or (3) plugged under my jurisdiction and was completed on (mo/day/year) **May 1, 1981** and this record is true to the best of my knowledge and belief. KansasWater Well Contractor's License No. **186** This Water Well Record was completed on (mo/day/yr) **June 26, 1981**under the business name of **Kellys Water Wells** by (signature) 

INSTRUCTIONS: Use typewriter or ball point pen, PLEASE PRESS FIRMLY and PRINT clearly. Please fill in blanks, underline or circle the correct answers. Send top three copies to Kansas Department of Health and Environment, Division of Environment, Environmental Geology Section, Topeka, KS 66620. Send one to WATER WELL OWNER and retain one for your records.