

WATER WELL RECORD

Form WWC-5

KSA 82a-1212

1 LOCATION OF WATER WELL:	Fraction County: Gray NW 1/4 NE 1/4 NW 1/4	Section Number 28	Township Number 26 S	Range Number R 29 NW
---------------------------	---	----------------------	-------------------------	-------------------------

Distance and direction from nearest town or city street address of well if located within city? **From Ingall, Ks. - 3 miles South, 2 miles West and 1 mile South**

2 WATER WELL OWNER: **Dennis Minet (Big Springs Drilling)**


RR#, St. Address, Box # :

Board of Agriculture, Division of Water Resources

City, State, ZIP Code : **Ingalls, Kansas 67853**

Application Number:

3 LOCATE WELL'S LOCATION WITH AN "X" IN SECTION BOX:

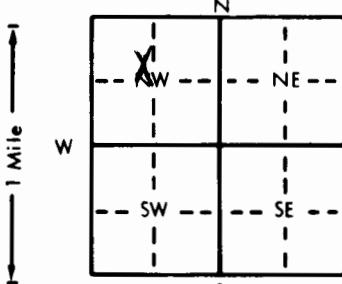

4 DEPTH OF COMPLETED WELL ft. ELEVATION:

Depth(s) Groundwater Encountered 1 ft. 2 ft. 3 ft.

WELL'S STATIC WATER LEVEL 105 ft. below land surface measured on mo/day/yr 8-4-83

Pump test data: Well water was ft. after hours pumping gpm

Est. Yield 90 gpm: Well water was ft. after hours pumping gpm

Bore Hole Diameter 8 in. to 212 ft., and in. to ft.

WELL WATER TO BE USED AS: 5 Public water supply 8 Air conditioning 11 Injection well

1 Domestic 3 Feedlot 6 Oil field water supply 9 Dewatering 12 Other (Specify below)

2 Irrigation 4 Industrial 7 Lawn and garden only 10 Observation well

Was a chemical/bacteriological sample submitted to Department? Yes No If yes, mo/day/yr sample was submitted

Water Well Disinfected? Yes No

5 TYPE OF BLANK CASING USED:

1 Steel 3 RMP (SR)
2 PVC 4 ABS

5 Wrought iron

8 Concrete tile

CASING JOINTS: Glued Clamped

6 Asbestos-Cement
7 Fiberglass

9 Other (specify below)

Welded

Threaded

Blank casing diameter 5 in. to 212 ft., Dia in. to ft., Dia in. to ft.

Casing height above land surface 12 in., weight 200 psi lbs./ft. Wall thickness or gauge No. SDR 21

TYPE OF SCREEN OR PERFORATION MATERIAL:

1 Steel 3 Stainless steel
2 Brass 4 Galvanized steel5 Fiberglass
6 Concrete tile

7 PVC

10 Asbestos-cement

8 RMP (SR)
9 ABS

11 Other (specify)

12 None used (open hole)

SCREEN OR PERFORATION OPENINGS ARE:

1 Continuous slot 3 Mill slot
2 Louvered shutter 4 Key punched5 Gauzed wrapped
6 Wire wrapped
7 Torch cut

8 Saw cut

11 None (open hole)

9 Drilled holes

10 Other (specify)

SCREEN-PERFORATED INTERVALS: From 172 ft. to 212 ft., From ft. to ft.

From ft. to ft., From ft. to ft.

GRAVEL PACK INTERVALS: From 10 ft. to 212 ft., From ft. to ft.

From ft. to ft., From ft. to ft.

6 GROUT MATERIAL: 1 Neat cement 2 Cement grout 3 Bentonite 4 Other

Grout Intervals: From 0 ft. to 10 ft., From ft. to ft., From ft. to ft.

What is the nearest source of possible contamination: **none** 10 Livestock pens
14 Abandoned water well1 Septic tank 4 Lateral lines 7 Pit privy 11 Fuel storage
2 Sewer lines 5 Cess pool 8 Sewage lagoon 12 Fertilizer storage
3 Watertight sewer lines 6 Seepage pit 9 Feedyard 13 Insecticide storage

15 Oil well/Gas well

16 Other (specify below)

Direction from well?

How many feet?

FROM	TO	LITHOLOGIC LOG	FROM	TO	LITHOLOGIC LOG
0	15	Top soil & clay			
15	30	0/Clay			
30	45	4/Clay & fine sand			
45	75	7/Fine sand			
75	90	9/Fine to medium sand			
90	120	120/5/Medium to coarse sand			
120	135	135/4/Medium to coarse sand & clay (3 ft.)			
135	150	150/1/Clay			
150	165	165/4/Clay (3 ft.), medium sand and Clay (2 ft.)			
165	180	180/5/Medium to coarse sand			
180	195	195/9/Coarse sand			
195	210	210/4/Coarse sand & clay			

7 CONTRACTOR'S OR LANDOWNER'S CERTIFICATION: This water well was (1) constructed, (2) reconstructed, or (3) plugged under my jurisdiction and was completed on (mo/day/year) **August 4, 1983** and this record is true to the best of my knowledge and belief. Kansas

Water Well Contractor's License No. **179** This Water Well Record was completed on (mo/day/yr) **Sept. 20, 1983** under the business name of **Joe's Well Service, Inc. Cimarron, Ks.** by (signature) **Larry C. Clark**

INSTRUCTIONS: Use typewriter or ball point pen, **PLEASE PRESS FIRMLY** and **PRINT** clearly. Please fill in blanks, underline or circle the correct answers. Send top three copies to Kansas Department of Health and Environment, Division of Environment, Environmental Geology Section, Topeka, KS 66620. Send one to WATER WELL OWNER and retain one for your records.