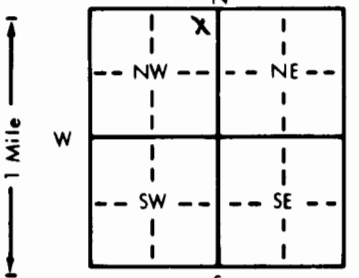


1 LOCATION OF WATER WELL:		Fraction		Section Number		Township Number		Range Number		
County: Gray		NE 1/4 NE 1/4 NW 1/4		33		T 26 S		R 29 E/W		
Distance and direction from nearest town or city street address of well if located within city? 5 1/2 south 2 3/4 west of Ingalls										
2 WATER WELL OWNER: D. G. Minet Mustang Drilling										
RR#, St. Address, Box #: Dodge City, Ks. Box 1609 Board of Agriculture, Division of Water Resources										
City, State, ZIP Code: Great Bend, Ks. 67530 Application Number: T83-17										
3 LOCATE WELL'S LOCATION WITH AN "X" IN SECTION BOX:			4 DEPTH OF COMPLETED WELL: 170 ft. ELEVATION:							
			Depth(s) Groundwater Encountered 1. 49 ft. 2. ft. 3. ft.							
			WELL'S STATIC WATER LEVEL 78 ft. below land surface measured on mo/day/yr 1-13-83							
			Pump test data: Well water was ft. after hours pumping gpm							
			Est. Yield NA gpm: Well water was ft. after hours pumping gpm							
Bore Hole Diameter 11 in. to 170 ft. and in. to ft.			WELL WATER TO BE USED AS:							
1 Domestic			3 Feedlot		6 Oil field water supply		8 Air conditioning		11 Injection well	
2 Irrigation			4 Industrial		7 Lawn and garden only		9 Dewatering		12 Other (Specify below)	
Was a chemical/bacteriological sample submitted to Department? Yes No X; If yes, mo/day/yr sample was submitted										
Water Well Disinfected? Yes HTH No										
5 TYPE OF BLANK CASING USED:										
1 Steel 3 RMP (SR) 5 Wrought iron 8 Concrete tile CASING JOINTS: Glued X Clamped										
2 PVC 4 ABS 6 Asbestos-Cement 9 Other (specify below) Welded										
7 Fiberglass Threaded										
Blank casing diameter 5 in. to 150 ft. Dia in. to ft.										
Casing height above land surface 18 in. weight lbs./ft. Wall thickness or gauge No. 258										
TYPE OF SCREEN OR PERFORATION MATERIAL:										
1 Steel 3 Stainless steel 5 Fiberglass 8 RMP (SR) 10 Asbestos-cement										
2 Brass 4 Galvanized steel 6 Concrete tile 9 ABS 11 Other (specify)										
12 None used (open hole)										
SCREEN OR PERFORATION OPENINGS ARE:										
1 Continuous slot 3 Mill slot 5 Gauzed wrapped 8 Saw cut 11 None (open hole)										
2 Louvered shutter 4 Key punched 6 Wire wrapped 9 Drilled holes										
7 Torch cut 10 Other (specify)										
SCREEN-PERFORATED INTERVALS: From 150 ft. to 170 ft. From ft. to ft.										
GRAVEL PACK INTERVALS: From 10 ft. to 170 ft. From ft. to ft.										
6 GROUT MATERIAL: 1 Neat cement 2 Cement grout 3 Bentonite 4 Other										
Grout Intervals: From 0 ft. to 10 ft. From ft. to ft. From ft. to ft.										
What is the nearest source of possible contamination:										
1 Septic tank 4 Lateral lines 7 Pit privy 10 Livestock pens 14 Abandoned water well										
2 Sewer lines 5 Cess pool 8 Sewage lagoon 11 Fuel storage 15 Oil well/Gas well										
3 Watertight sewer lines 6 Seepage pit 9 Feedyard 12 Fertilizer storage 16 Other (specify below)										
13 Insecticide storage										
Direction from well? west How many feet? 80										
FROM TO LITHOLOGIC LOG FROM TO LITHOLOGIC LOG										
0 3 Sandy top soil										
3 37 Brown sandy clay										
37 40 Fine sand & gravel										
40 65 Brown and white clay										
65 123 Sand and gravel										
123 135 Clay and gravel mixed										
135 150 Sand and gravel										
150 165 Clay & gravel mixed										
165 170 Shale										
7 CONTRACTOR'S OR LANDOWNER'S CERTIFICATION: This water well was (1) constructed, (2) reconstructed, or (3) plugged under my jurisdiction and was completed on (mo/day/year) 1-13-83 and this record is true to the best of my knowledge and belief. Kansas										
Water Well Contractor's License No. 134 This Water Well Record was completed on (mo/day/yr) 2-5-83										
under the business name of Rosencrantz-Bemis Ent. by (signature) Lora Dodson										
INSTRUCTIONS: Use typewriter or ball point pen, PLEASE PRESS FIRMLY and PRINT clearly. Please fill in blanks, underline or circle the correct answers. Send top three copies to Kansas Department of Health and Environment, Division of Environment, Environmental Geology Section, Topeka, KS 66620. Send one to WATER WELL OWNER and retain one for your records.										