

CORRECTION(S) TO WATER WELL RECORD (WWC-5)
(to rectify lacking or incorrect information)

Location listed as:

Section-Township-Range: 6 - 26 S - 28 W

Fraction ($\frac{1}{4}$ $\frac{1}{4}$ $\frac{1}{4}$): NW NW

County: Gray

Location changed to:

1 - 26 S - 29 W

NW NW NW

Other changes: Initial statements: _____

Changed to: _____

Comments: _____

verification method: written description, city map, and mapping
tool & aerial photos on KGS website.

initials: DR date: 1/27/2009

submitted by: Kansas Geological Survey, Data Resources Library, 1930 Constant Ave., Lawrence, KS 66047-3726
to: Kansas Dept of Health & Environment, Bureau of Water, 1000 SW Jackson, Suite 420, Topeka, KS 66612-1367.


1 LOCATION OF WATER WELL:	Fraction 1/4 NW 1/4 NW 1/4	Section Number 6	Township Number T 26 S	Range Number R 28 E
---------------------------	-------------------------------	---------------------	---------------------------	------------------------

Distance and direction from nearest town or city street address of well if located within city?

South of high school near railroad tracks, Ingalls

2 WATER WELL OWNER:	KDHE 1000 SW Jackson St., Suite 410 Topeka, KS 66612-1367	Board of Agriculture, Division of Water Resources Application Number:
---------------------	---	--

3 LOCATE WELL'S LOCATION WITH AN "X" IN SECTION BOX:	4 DEPTH OF COMPLETED WELL 120 ft. ELEVATION: 0 ft.
---	--

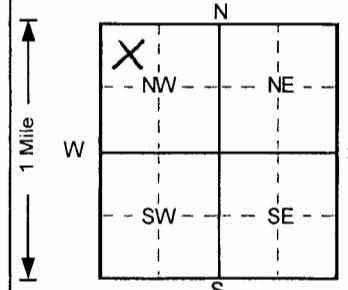

Depth(s) Groundwater Encountered 1 ft. 2 ft. 3 ft.
WELL'S STATIC WATER LEVEL 40.54 ft. below land surface measured on mo/day/yr 10/20/2004
Pump test data: Well water was NA ft. after hours pumping gpm
Est. Yield NA gpm: Well water was ft. after hours pumping gpm
Bore Hole Diameter 8 in. to 150 ft. and in. to ft.
WELL WATER TO BE USED AS: 5 Public water supply 8 Air conditioning 11 Injection well
1 Domestic 3 Feedlot 6 Oil field water supply 9 Dewatering 12 Other (Specify below)
2 Irrigation 4 Industrial 7 Lawn and garden only 10 Monitoring well
Was a chemical/bacteriological sample submitted to Department? Yes No If yes, mo/day/yr sample was submitted
Water Well Disinfected? Yes No ✓

5 TYPE OF BLANK CASING USED:	5 Wrought iron 8 Concrete tile CASING JOINTS: Glued Clamped
1 Steel 3 RMP (SR) 6 Asbestos-Cement 9 Other (specify below) Welded	
2 PVC 4 ABS 7 Fiberglass Threaded. ✓	

Blank casing diameter 4 in. to 100 ft. Dia in. to ft. Dia in. to ft.

Casing height above land surface 0 in., weight lbs./ft. Wall thickness or gauge No. Sch. 40

TYPE OF SCREEN OR PERFORATION MATERIAL	7 PVC 10 Asbestos-cement
1 Steel 3 Stainless steel 5 Fiberglass 8 RMP (SR) 11 Other (specify)	
2 Brass 4 Galvanized steel 6 Concrete tile 9 ABS 12 None used (open hole)	

SCREEN OR PERFORATION OPENINGS ARE:	5 Gauzed wrapped 8 Saw cut 11 None (open hole)
1 Continuous slot 3 Mill slot 6 Wire wrapped 9 Drilled holes	
2 Louvered shutter 4 Key punched 7 Torch cut 10 Other (specify)	

SCREEN-PERFORATED INTERVALS: From 100 ft. to 120 ft. From ft. to ft.

From ft. to ft. From ft. to ft.

GRAVEL PACK INTERVALS: From 30 ft. to 150 ft. From ft. to ft.

From ft. to ft. From ft. to ft.

6 GROUT MATERIAL:	1 Neat cement 2 Cement grout 3 Bentonite 4 Other
Grout Intervals: From 10 ft. to 25 ft. From 25 ft. to 30 ft. From ft. to ft.	
What is the nearest source of possible contamination:	10 Livestock pens 14 Abandoned water well
1 Septic tank 4 Lateral lines 7 Pit privy 11 Fuel storage 15 Oil well/Gas well	
2 Sewer lines 5 Cess pool 8 Sewage lagoon 12 Fertilizer storage 16 Other (specify below)	
3 Watertight sewer lines 6 Seepage pit 9 Feedyard 13 Insecticide storage	
Direction from well? NW	How many feet? 120








Fmr. fertilizer storage

How many feet? 120

