

**CORRECTION(S) TO WATER WELL RECORD (WWC-5)**  
(to rectify lacking or incorrect information)

Location listed as:

Section-Township-Range: 6-26 S-28 W

Fraction ( 1/4 1/4 1/4): NW NW NW

County: Gray

Location changed to:

1-26 S-29 W

NW NW NW

Other changes: Initial statements: \_\_\_\_\_

Changed to: \_\_\_\_\_

Comments: \_\_\_\_\_

verification method: Written description, city map, and mapping tool & aerial photos on KGS website.

initials: DR date: 1/27/2009

submitted by: Kansas Geological Survey, Data Resources Library, 1930 Constant Ave., Lawrence, KS 66047-3726  
to: Kansas Dept of Health & Environment, Bureau of Water, 1000 SW Jackson, Suite 420, Topeka, KS 66612-1367.

## WATER WELL RECORD Form WWC-5 KSA 82a-1212

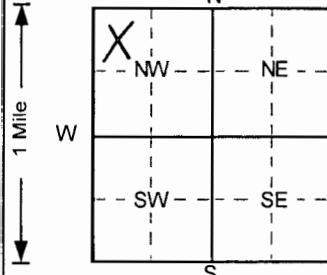
1 LOCATION OF WATER WELL:	Fraction 1/4 NW 1/4 NW 1/4	Section Number 6	Township Number T 26 S	Range Number R 28 E
---------------------------	-------------------------------	---------------------	---------------------------	------------------------

Distance and direction from nearest town or city street address of well if located within city?

South of high school near railroad tracks, Ingalls

2 WATER WELL OWNER:	KDHE 1000 SW Jackson St., Suite 410 Topeka, KS 66612-1367	Board of Agriculture, Division of Water Resources Application Number:
---------------------	---	--

3 LOCATE WELL'S LOCATION WITH AN "X" IN SECTION BOX:	4 DEPTH OF COMPLETED WELL ..... 125 ..... ft. ELEVATION: ..... 0 ..... ft.
--	--

	Depth(s) Groundwater Encountered 1 ..... ft. 2 ..... ft. 3 ..... ft.
	WELL'S STATIC WATER LEVEL ..... 37.75 ..... ft. below land surface measured on mo/day/yr ..... 10/20/2004
	Pump test data: Well water was ..... NA ..... ft. after ..... hours pumping ..... gpm
	Est Yield ..... NA ..... gpm: Well water was ..... ft. after ..... hours pumping ..... gpm
	Bore Hole Diameter ..... 8 ..... in. to ..... 152 ..... ft. and ..... in. to ..... ft.
	WELL WATER TO BE USED AS: 5 Public water supply 8 Air conditioning 11 Injection well
	1 Domestic 3 Feedlot 6 Oil field water supply 9 Dewatering 12 Other (Specify below)
	2 Irrigation 4 Industrial 7 Lawn and garden only 10 Monitoring well
	Was a chemical/bacteriological sample submitted to Department? Yes ..... No ..... If yes, mo/day/yr sample was submitted
	Water Well Disinfected? Yes ..... No ..... ✓

5 TYPE OF BLANK CASING USED:	5 Wrought iron 8 Concrete tile Casing Joints: Glued ..... Clamped .....
1 Steel 3 RMP (SR) 6 Asbestos-Cement 9 Other (specify below) Welded .....	
2 PVC 4 ABS 7 Fiberglass ..... Threaded. ✓	

Blank casing diameter ..... 4 ..... in. to ..... 105 ..... ft. Dia ..... in. to ..... ft. Dia ..... in. to ..... ft.

Casing height above land surface ..... 0 ..... in., weight ..... lbs./ft. Wall thickness or gauge No. ..... Sch.40 .....

TYPE OF SCREEN OR PERFORATION MATERIAL	7 PVC 10 Asbestos-cement
1 Steel 3 Stainless steel 5 Fiberglass 8 RMP (SR) 11 Other (specify) .....	
2 Brass 4 Galvanized steel 6 Concrete tile 9 ABS 12 None used (open hole) .....	

SCREEN OR PERFORATION OPENINGS ARE:	5 Gauzed wrapped 8 Saw cut 11 None (open hole)
1 Continuous slot 3 Mill slot 6 Wire wrapped 9 Drilled holes	
2 Louvered shutter 4 Key punched 7 Torch cut 10 Other (specify) .....	

SCREEN-PERFORATED INTERVALS: From ..... 105 ..... ft. to ..... 125 ..... ft. From ..... ft. to ..... ft.

NOV 22 2004

From ..... ft. to ..... ft. From ..... ft. to ..... ft.

GRAVEL PACK INTERVALS: From ..... 40.5 ..... ft. to ..... 152 ..... ft. From ..... ft. to ..... ft.

BUREAU OF WATER

6 GROUT MATERIAL:	1 Neat cement 2 Cement grout 3 Bentonite 4 Other .....
Grout Intervals: From ..... 0 ..... ft. to ..... 35 ..... ft. From ..... 35 ..... ft. to ..... 40.5 ..... ft. From ..... ft. to ..... ft.	

What is the nearest source of possible contamination:

1 Septic tank 4 Lateral lines 7 Pit privy 10 Livestock pens 14 Abandoned water well
2 Sewer lines 5 Cess pool 8 Sewage lagoon 11 Fuel storage 15 Oil well/Gas well
3 Watertight sewer lines 6 Seepage pit 9 Feedyard 12 Fertilizer storage 16 Other (specify below) .....

16 Other (specify below) .....

Fmr. fertilizer storage

Direction from well? NW

FROM	TO	LITHOLOGIC LOG	FROM	TO	PLUGGING INTERVALS
0	5	Silt w/Sand, fine to coarse, subangular, Dark			
5	10	Sand w/Silt, fine to coarse, Brown			
10	15	Sand w/Silt, fine to coarse, Grayish Brown			
15	35	Sand w/Silt, fine to coarse, Grayish Brown			
35	70	Gravel and Sand, tr. Clay, Yellowish Brown			
70	75	Sand, fine to coarse, tr. fine gravel, Brown			
75	105	Sand, fine to coarse, little Clay, Yellowish Bro			
105	115	Gravel, sandy, tr. Clay, Very Pale Brown			
115	125	Sand, clayey, tr. fine to coarse gravel, Pale Br			
125	145	Sand, clayey, tr. fine gravel, Brown			
145	152	Clay, tr. fine grained Sand, Very Pale Brown			
					KDHE Project Code C606971817
					MW2, Flushmount
					Project Name: Golder - Ingalls PWS
					GeoCore # 1184, #

7 CONTRACTOR'S OR LANDOWNER'S CERTIFICATION: This water well was (1) constructed, (2) reconstructed, or (3) plugged under my jurisdiction and was completed on (mo/day/year) ..... 10/18/2004 ..... and this record is true to the best of my knowledge and belief.

Kansas Water Well Contractor's License No. ..... 527 ..... This Water Well Record was completed on (mo/day/yr) ..... 11/5/2004 ..... under the business name of GeoCore, Inc. by (signature) 