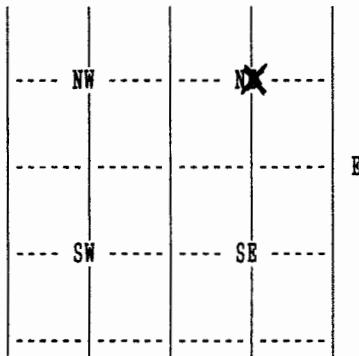


## WATER WELL RECORD Form WWC-5 KSA 82a-1212

1 LOCATION OF WATER WELL: COUNTY: 035 GRAY	Fraction N/C	NE 1/4	Section Number 03	Township Number T 26 S	Range Number R 29 W
-----------------------------------------------	-----------------	--------	----------------------	---------------------------	------------------------

Distance and direction from nearest town or city street address of well if located within city?  
FROM CIMARRON; APPX 6 1/4 MILES WEST & 1/4 MILE NORTH

2 WATER WELL OWNER: RR#, St. Address, Box # : RT 1 BOX 92 City, State, ZIP code : JETMORE, KS 67854-9745	IRSIK G & B FARMS Board of Agriculture, Division of Water Resources Application Number: 24905
3 LOCATE WELL'S LOCATION WITH AN "X" IN SECTION BOX:	4 DEPTH OF COMPLETED WELL 190 ELEVATION: 0 Depth(s) Groundwater Encountered 1. 0 ft. 2. 0 ft. 3. 0 ft.
 NW NE SW SE	WELL'S STATIC WATER LEVEL 87 ft. below land surface measured on mo/day/yr 05/27/05 Pump test data: Well water was 147 ft. after 4 hours pumping 800 gpm Estimated Yield 0 gpm: Well water was 0 ft. after 0 hours pumping 0 gpm Bore Hole Diameter 24 in. to 190 ft., and in. to 0 ft. WELL WATER TO BE USED AS: 02 IRRIGATION Was a chemical/bacteriological sample submitted to department? No ; If yes, mo/day/yr sample was submitted Water well disinfected? Yes

5 TYPE OF BLANK CASING USED: 01 STEEL Blank casing diameter 16 in. to 190 ft., Dia in. to 0 ft., Dia in. to 0 ft. Casing height above land surface 12 in., weight 42 lbs/ft. Wall thickness or gauge No. .250 TYPE OF SCREEN OR PERFORATION MATERIAL: 01 STEEL SCREEN OR PERFORATION OPENINGS ARE: 01 CONT. SLOT	CASING JOINTS: WELDED
SCREEN PERFORATED INTERVALS: From 121 ft. to 171 ft., From 0 ft. to 0 ft. From 0 ft. to 0 ft., From 0 ft. to 0 ft.	
GRAVEL PACK INTERVALS: From 20 ft. to 190 ft., From 0 ft. to 0 ft. From 0 ft. to 0 ft., From 0 ft. to 0 ft.	

6 GROUT MATERIAL 03 BENTONITE Grout Intervals: From 0 ft. to 20 ft., From 0 ft. to 0 ft., From 0 ft. to 0 ft. What is the nearest source of possible contamination: WATER WELL Direction from well? SOUTH	How many feet? 80
---	-------------------

FROM	TO	LITHOLOGIC LOG	FROM	TO	PLUGGING INTERVALS
0	2	02 SILT			
2	8	07 FINE SAND			
8	42	05 SAND 11 GRAVEL			
42	53	04 SANDY CLAY			
53	64	05 SAND 11 GRAVEL			
64	75	01 CLAY			
75	82	07 FINE SAND 08 MEDIUM SAND			
82	98	01 CLAY			
98	136	05 SAND 01 CLAY			
136	143	04 SANDY CLAY			

7 CONTRACTOR'S OR LANDOWNER'S CERTIFICATION: This water well was Constructed under my jurisdiction and was completed on (mo/day/year) 05/26/05 and this record is true to the best of my knowledge and belief. Kansas Water Well Contractor's License No. 145 This Water Well Record was completed on (mo/day/yr) 08/09/05 under the business name of HENKLE DRILLING & SUPPLY	by (signature)
---	----------------

(Continued)

WATER WELL RECORD Form WWC-5 KSA 82a-1212

1 LOCATION OF WATER WELL: COUNTY: 035 GRAY	Fraction 1/4 NE 1/4 NE 1/4	Section Number 03	Township Number T 26 S	Range Number R 29 W
-----------------------------------------------	-------------------------------	----------------------	---------------------------	------------------------

2 WATER WELL OWNER: IRSIK G & B FARMS

RR#, St. Address, Box # : RT 1 BOX 92

City, State, ZIP code : JETMORE, KS 67854-9745

Board of Agriculture, Division of Water Resources

Application Number: 24905

FROM 143	TO 171	LITHOLOGIC LOG
171	180	05 SAND 28 ROCK
		19 SHALE

7 CONTRACTOR'S OR LANDOWNER'S CERTIFICATION: This water well was Constructed under my jurisdiction and was completed on (mo/day/year) 05/26/05 and this record is true to the best of my knowledge and belief. Kansas Water Well Contractor's License No. 145 This Water Well Record was completed on (mo/day/yr) 08/09/07 under the business name of HENKLE DRILLING & SUPPLY

by (signature)

