

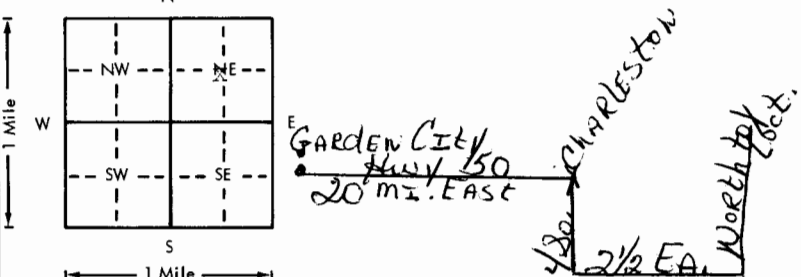
USE TYPEWRITER OR BALL  
POINT PEN-PRESS FIRMLY,  
PRINT CLEARLY.

WATER WELL RECORD  
KSA 82a-1201-1215

Kansas Department of Health and  
Environment-Division of Environment  
(Water well Contractors)  
Topeka, Kansas 66620

CWW Inv. #13575

E/2 SW/4 NE/4

1. Location of well:		County	1980 FNL-1660FEL	Section number	Township number	Range number
Gray		1/4 1/4 1/4	5	T 26S	S R 29W	E/W
2. Distance and direction from nearest town or city: From Garden City go 20 mi. Ea. on Hwy 50 to Charleston, KS then 4 mi. So - 2 1/2 mi Ea. - North to loc.				3. Owner of well: Rains & Williamson Oil Co. R.R. or street: 435 Page Court, 220 W. Douglas City, state, zip code: Wichita, KS 67202		
4. Locate with "X" in section below: Sketch map:				6. Bore hole dia. 9 in. Completion date 6/20 Well depth 200 ft.		
				7. Cable tool <input checked="" type="checkbox"/> Rotary <input type="checkbox"/> Driven <input type="checkbox"/> Dug <input type="checkbox"/> Hollow rod <input type="checkbox"/> Jetted <input type="checkbox"/> Bored <input type="checkbox"/> Reverse rotary		
5. Type and color of material				8. Use: <input type="checkbox"/> Domestic <input type="checkbox"/> Public supply <input checked="" type="checkbox"/> Industry <input type="checkbox"/> Irrigation <input type="checkbox"/> Air conditioning <input type="checkbox"/> Stock <input type="checkbox"/> Lawn <input checked="" type="checkbox"/> Oil field water <input type="checkbox"/> Other		
Surface				9. Casing: Material <input type="checkbox"/> Threaded <input type="checkbox"/> Welded <input type="checkbox"/> Surface <input type="checkbox"/> 28 in. RMP <input type="checkbox"/> PVC <input checked="" type="checkbox"/> Weight 2.78 lbs./ft. Dia. 5 in. to 75 ft. depth Wall Thickness: inches or Dia. 5 in. to 200 ft. depth gage No. 265		
Medium to large sand				10. Screen: Manufacturer's name <input type="checkbox"/> Sawed per 1.		
Sandy clay				Type PVC Dia. 5 in. Slot/gauze .030 Length 100 ft. Set between 75 ft. and 175 ft. ft. and ft. Gravel pack? yes Size range of material 1/8-3/16		
Medium to large sand & sandy clay 70-30				11. Static water level: 75 ft. below land surface Date 6/20/77		
				12. Pumping level below land surfaces: ft. after hrs. pumping g.p.m. ft. after hrs. pumping g.p.m. Estimated maximum yield 40 g.p.m.		
				13. Water sample submitted: Yes <input checked="" type="checkbox"/> No <input type="checkbox"/> Date		
				14. Well head completion: Pitless adapter 28 inches above grade		
				15. Well grouted? yes With: <input checked="" type="checkbox"/> Neat cement <input type="checkbox"/> Bentonite <input type="checkbox"/> Concrete Depth: From 0 ft. to 10 ft.		
				16. Nearest source of possible contamination: ft. 100 Direction NE Type oil well Well disinfected upon completion? <input checked="" type="checkbox"/> Yes <input type="checkbox"/> No		
				17. Pump: <input checked="" type="checkbox"/> Not installed Manufacturer's name Model number HP Volts Length of drop pipe ft. capacity g.p.m. Type: <input type="checkbox"/> Submersible <input type="checkbox"/> Turbine <input type="checkbox"/> Jet <input type="checkbox"/> Reciprocating <input type="checkbox"/> Centrifugal <input type="checkbox"/> Other		
(Use a second sheet if needed)						
18. Elevation:		19. Remarks:		20. Water well contractor's certification: This well was drilled under my jurisdiction and this report is true to the best of my knowledge and belief. Carlile Water Well Service 118 Business name box 275, Liberal, KS License No. Address Signed Edward E. Mean Date 7/12 Authorized representative		
Topography: <input type="checkbox"/> Hill <input type="checkbox"/> Slope <input checked="" type="checkbox"/> Upland <input type="checkbox"/> Valley						

Forward the white, blue and pink copies to the Department of Health and Environment

Form WWC-5