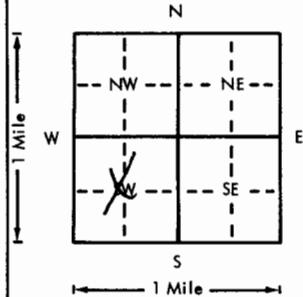
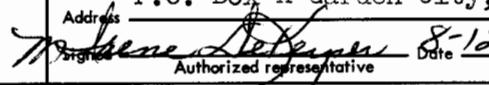


USE TYPEWRITER OR BALL
POINT PEN-PRESS FIRMLY,
PRINT CLEARLY.

WATER WELL RECORD
KSA 82a-1201-1215

Kansas Department of Health and
Environment-Division of Environment
(Water well Contractors)
Topeka, Kansas 66620

| | | | | | |
|---|--|--|--|---------------------------|-------------------------|
| 1. Location of well: | County GRAY | Fraction SE SW 1/4 NW 1/4 SW 1/4 | Section number 12 | Township number T 26 S | Range number R 29 NW |
| 2. Distance and direction from nearest town or city Bridge 5 3/4 west 1 1/4 north Street address of well location if in city: | 3. Owner of well: Charles Thomas R.R. or street: Cimmaron, Ks 67835 City, state, zip code: | | | | |
| 4. Locate with "X" in section below:  | Sketch map: | | 6. Bore hole dia. 26 in. Completion date 7-28-76 Well depth. 220 ft. | | |
| 5. Type and color of material | From | To | 7. <input type="checkbox"/> Cable tool <input type="checkbox"/> Rotary <input type="checkbox"/> Driven <input type="checkbox"/> Dug <input type="checkbox"/> Hollow rod <input type="checkbox"/> Jetted <input type="checkbox"/> Bored <input checked="" type="checkbox"/> Reverse rotary | | |
| | | | 8. Use: <input type="checkbox"/> Domestic <input type="checkbox"/> Public supply <input type="checkbox"/> Industry <input checked="" type="checkbox"/> Irrigation <input type="checkbox"/> Air conditioning <input type="checkbox"/> Stock <input type="checkbox"/> Lawn <input type="checkbox"/> Oil field water <input type="checkbox"/> Other | | |
| | | | 9. Casing: Material <input type="checkbox"/> Steel <input type="checkbox"/> Height: Above or below Threaded <input type="checkbox"/> Welded <input checked="" type="checkbox"/> Surface 12 in. RMP <input type="checkbox"/> PVC <input type="checkbox"/> Weight 36.87 lbs./ft. Dia. 16 in. to 22 ft. depth Wall Thickness: inches or Dia. <input type="checkbox"/> in. to <input type="checkbox"/> ft. depth gage No. <input type="checkbox"/> | | |
| | | | 10. Screen: Manufacturer's name Johnson Division Type Galv. 16" Dia. 20' Slot/gauge 100 Length 20' Set between 180 ft. and 200 ft. Perf. 80-180 ft. and 200-210 ft. Gravel pack <input type="checkbox"/> Size range of material 1-11 Diam. | | |
| | | | 11. Static water level: mo./day/yr. 57 ft. below land surface Date 1-7-76 | | |
| | | | 12. Pumping level below land surfaces: 81 ft. after 3 hrs. pumping 1500 g.p.m. ft. after hrs. pumping g.p.m. Estimated maximum yield 1500 g.p.m. | | |
| | | | 13. Water sample submitted: mo./day/yr. Yes <input checked="" type="checkbox"/> No Date | | |
| | | | 14. Well head completion: Pitless adapter 12 inches above grade | | |
| | | | 15. Well grouted? <input checked="" type="checkbox"/> With: Neat cement <input type="checkbox"/> Bentonite <input type="checkbox"/> Concrete Depth: From 0 ft. to 10 ft. N/A | | |
| | | | 16. Nearest source of possible contamination: ft. Direction Type Well disinfected upon completion? Yes <input checked="" type="checkbox"/> No | | |
| | | | 17. Pump: Not installed Manufacturer's name Goulds US Pumps Model number 12" HP 125 Volts Length of drop pipe 110 ft. capacity 1000 g.p.m. Type: <input type="checkbox"/> Submersible <input checked="" type="checkbox"/> Turbine <input type="checkbox"/> Jet <input type="checkbox"/> Reciprocating <input type="checkbox"/> Centrifugal <input type="checkbox"/> Other | | |
| (Use a second sheet if needed) | | | 18. Elevation: 19. Remarks: Topography: <input checked="" type="checkbox"/> Hill <input type="checkbox"/> Slope <input type="checkbox"/> Upland <input type="checkbox"/> Valley | | |
| | | | 20. Water well contractor's certification: This well was drilled under my jurisdiction and this report is true to the best of my knowledge and belief. Minter Wilson Drilling 208 Business name P.O. Box A Garden City, KS Address  Authorized representative 8-12-77 Date | | |

Professionals

MINTER-WILSON DRILLING CO.
INCORPORATED

Irrigation
and Domestic
Water Systems
Complete Installation
and Repairing

Phone 276-8269 • P.O. Box 493 • GARDEN CITY, KANSAS 67846

TEST NO. 1000

50' DEEP

100' D.

LOCATION: SW 1/4-16-24
Off of 1/2' East of Pivot

STATIC WATER LEVEL: 50'

| | | |
|---------|-----|--|
| TEST #3 | 113 | |
| 2 | 1 | Top Soil |
| 1 | 10 | Fine Sand |
| 33 | 12 | Med. To Coarse Gravel |
| 42 | 17 | Brown Sandy Clay |
| 47 | 1 | Fine To Med. Sand & Gravel |
| 61 | 104 | Brown Sandy Clay |
| 104 | 113 | Fine To Med. Sand & Gravel (loose) |
| 113 | 111 | Brown Sandy Clay |
| 121 | 131 | Fine To Med. Sand |
| 131 | 165 | Brown Sandy Clay |
| 165 | 170 | Fine To Med. Sand |
| 170 | 205 | Med. To Coarse Gravel mixed with Brown, Yellow Rock (loose) |
| 205 | 216 | Brown Sandy Clay |
| 214 | 220 | Med. To Coarse Gravel mixed with Brown, Yellow Rock |
| 220 | 235 | Brown Sandy Clay |
| 232 | 236 | Brown, Yellow Clay |
| 236 | 240 | Shale |
| 240 | 270 | 7' Pl. 100' Perf. 10' Jersey 20' Perf. 40' Pl. |