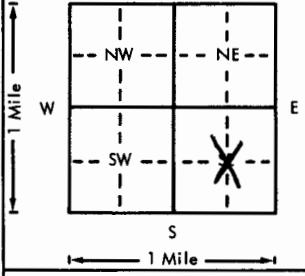


USE TYPEWRITER OR BALL
POINT PEN-PRESS FIRMLY,
PRINT CLEARLY.

WATER WELL RECORD
KSA 82a-1201-1215

Kansas Department of Health and
Environment-Division of Environment
(Water well Contractors)
Topeka, Kansas 66620

1. Location of well:	County GRAY	Fraction SE 1/4 NW 1/4 SE 1/4	Section number 13	Township number T 26 S	Range number R 29 E/W
2. Distance and direction from nearest town or city: Cimmaron river bridge 5 1/4 west 1 1/4 north Street address of well location if in city:			3. Owner of well: R.R. or street: City, state, zip code:	Charles Thomas Cimmaron, Ks. 67835	
4. Locate with "X" in section below: Sketch map: N 			6. Bore hole dia. 26 in. Completion date 4-31-76 Well depth 258 ft.		
				7. <input type="checkbox"/> Cable tool <input type="checkbox"/> Rotary <input type="checkbox"/> Driven <input type="checkbox"/> Dug <input type="checkbox"/> Hollow rod <input type="checkbox"/> Jetted <input type="checkbox"/> Bored <input checked="" type="checkbox"/> Reverse rotary	
				8. Use: <input type="checkbox"/> Domestic <input type="checkbox"/> Public supply <input type="checkbox"/> Industry <input checked="" type="checkbox"/> Irrigation <input type="checkbox"/> Air conditioning <input type="checkbox"/> Stock <input type="checkbox"/> Lawn <input type="checkbox"/> Oil field water <input type="checkbox"/> Other	
				9. Casing: Material steel Height: Above or below Threaded <input type="checkbox"/> Welded <input checked="" type="checkbox"/> Surface 12 in. RMP <input type="checkbox"/> PVC <input type="checkbox"/> Weight 36.87 lbs./ft. Dia. 16 in. 259 ft. depth Wall Thickness: inches or Dia. <input type="checkbox"/> in. to <input type="checkbox"/> ft. depth gage No.	
				10. Screen: Manufacturer's name Wilson Division Type Galv. Dia. 16" Slot/gauze 100 Length 20' Set between 200 ft. and 220 ft. Perf. 100-200 ft. and 220-258 ft. Gravel pack? YES Size range of material 12" down	
				11. Static water level: mo./day/yr. 63 ft. below land surface Date 4-2-76	
				12. Pumping level below land surfaces: 83 ft. after 3 hrs. pumping 1125 g.p.m. ft. after hrs. pumping g.p.m. Estimated maximum yield 1125 g.p.m.	
				13. Water sample submitted: mo./day/yr. Yes <input checked="" type="checkbox"/> No Date	
				14. Well head completion: Pitless adapter 12 inches above grade	
				15. Well grouted? yes With: Neat cement <input type="checkbox"/> Bentonite <input type="checkbox"/> Concrete Depth: From 0 ft. to 10 ft. N/A	
				16. Nearest source of possible contamination: ft. Direction Type Well disinfected upon completion? Yes <input checked="" type="checkbox"/> No	
				17. Pump: Not installed Manufacturer's name Goulds USpumps Model number 1211 HP 125 Volts Length of drop pipe 160 ft. capacity 1000 g.p.m. Type: <input type="checkbox"/> Submersible <input checked="" type="checkbox"/> Turbine <input type="checkbox"/> Jet <input type="checkbox"/> Reciprocating <input type="checkbox"/> Centrifugal <input type="checkbox"/> Other	
				18. Elevation: Topography: <input type="checkbox"/> Hill <input checked="" type="checkbox"/> Slope <input type="checkbox"/> Upland <input type="checkbox"/> Valley	19. Remarks: Drilling done by Central Well & Pump Pratt, Ks.
				20. Water well contractor's certification: This well was drilled under my jurisdiction and this report is true to the best of my knowledge and belief. Minter Wilson Drilling 208 Business name P.O. Box A Garden City, KS Address <i>Minter Wilson Drilling</i> 8-3-76 Signature <i>Minter Wilson</i> Date 8-3-76 Authorized representative	

Forward the white, blue and pink copies to the Department of Health and Environment

Form WWC-5

The Professionals MINTER-WILSON DRILLING CO. INCORPORATED

Irrigation
and Domestic
Water Systems
Complete Installation
and Repairing

Phone 276-8269 • P.O. Box 493 • GARDEN CITY, KANSAS 67846

CHARLES THOMAS
GRAY COUNTY
3-2-76

LOCATION: SE $\frac{1}{4}$ 13-26-29
40 Feet East Of Pivot

STATIC WATER LEVEL: 70'

TEST #10 PIVOT 21
0 1 Top Soil
1 38 Fine Sand
38 45 Brown Sandy Clay
45 54 Fine To Med. Sand & Gravel
54 65 Coarse Gravel (Loose)
65 79 Fine To Med. Sand & Gravel
79 85 Cement Sand Stone (Hard)
85 100 Fine To Med. Sand
100 142 Fine To Med. Sand & Gravel (Loose)
142 161 Gravel & Clay Streak Mixed
161 180 Brown Sandy Clay
180 189 Fine To Med. Sand & Gravel (Loose)
189 196 Brown Sandy Clay
196 201 Fine To Med. Sand
201 220 Med. To Coarse Gravel Mixed Brown, Yellow
Rock
220 242 Brown Sandy Clay
242 258 Med. Coarse Gravel, Mixed Brown, Yellow (Tight)
258 265 Yellow Shale