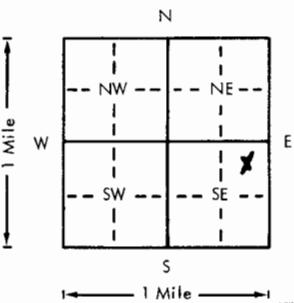


USE TYPEWRITER OR BALL
POINT PEN-PRESS FIRMLY,
PRINT CLEARLY.

WATER WELL RECORD
KSA 82a-1201-1215

Kansas Department of Health and
Environment-Division of Environment
(Water well Contractors)
Topeka, Kansas 66620

1. Location of well:	County	Fraction	Section number	Township number	Range number	
	Gray	NE 1/4 NE 1/4 SE 1/4	16	T 26	S R 29 E/W	
2. Distance and direction from nearest town or city: 4 m. south 1 west from Ingalls, Kansas Street address of well location if in city:	3. Owner of well: R.R. or street: City, state, zip code:			Slawson Drilling Box 1131 Great Bend, Kansas 67530		
4. Locate with "X" in section below: 	Sketch map:			6. Bore hole dia. 11 in. Completion date _____ Well depth 200 ft. 8-28-79		
5. Type and color of material	From	To	7. <input type="checkbox"/> Cable tool <input checked="" type="checkbox"/> Rotary <input type="checkbox"/> Driven <input type="checkbox"/> Dug <input type="checkbox"/> Hollow rod <input type="checkbox"/> Jetted <input type="checkbox"/> Bored <input type="checkbox"/> Reverse rotary			
sandy top soil	0	2	8. Use: <input type="checkbox"/> Domestic <input type="checkbox"/> Public supply <input type="checkbox"/> Industry <input type="checkbox"/> Irrigation <input type="checkbox"/> Air conditioning <input type="checkbox"/> Stock <input type="checkbox"/> Lawn <input checked="" type="checkbox"/> Oil field water <input type="checkbox"/> Other			
fine sand and gravel	2	33	9. Casing: Material PVC Height: Above or below Threaded <input type="checkbox"/> Welded <input type="checkbox"/> Surface 12 in. RMP <input type="checkbox"/> PVC <input checked="" type="checkbox"/> Weight _____ lbs./ft. Dia. 1/2 in. to 200 ft. depth Wall Thickness: inches or Dia. _____ in. to _____ ft. depth gage No. .258			
clay	33	37	10. Screen: Manufacturer's name certain teed			
fine sand and gravel	37	58	11. Static water level: 78 ft. below land surface Date 8-28-79 mo./day/yr.			
sand and gravel	58	83	12. Pumping level below land surfaces: ____ ft. after ____ hrs. pumping ____ g.p.m. ____ ft. after ____ hrs. pumping ____ g.p.m.			
clay	83	135	Estimated maximum yield _____ g.p.m.			
sand and gravel	135	142	13. Water sample submitted: Yes <input checked="" type="checkbox"/> No Date 8-28-79 mo./day/yr.			
clay	142	173	14. Well head completion: No Pitless adapter _____ inches above grade			
sand and gravel	173	200	15. Well grouted? <input checked="" type="checkbox"/> With: <input checked="" type="checkbox"/> Neat cement <input checked="" type="checkbox"/> Bentonite <input type="checkbox"/> Concrete Depth: From 0 ft. to 10 ft.			
(Use a second sheet if needed)						
18. Elevation:	19. Remarks: Topography: <input type="checkbox"/> Hill <input type="checkbox"/> Slope <input checked="" type="checkbox"/> Upland <input type="checkbox"/> Valley					20. Water well contractor's certification: This well was drilled under my jurisdiction and this report is true to the best of my knowledge and belief. <u>Rosencrantz-Bemis 134</u> Business name <u>Bom 713 Great Bend, Ks.</u> License No. Address <u>Great Bend, Ks.</u> Signed <u>Media Dodson</u> Date <u>9/17/79</u> Authorized representative