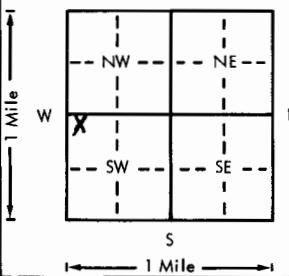
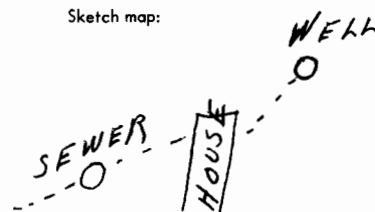


USE TYPEWRITER OR BALL
POINT PEN-PRESS FIRMLY,
PRINT CLEARLY.

WATER WELL RECORD
KSA 82a-1201-1215

Kansas Department of Health and
Environment-Division of Environment
(Water well Contractors)
Topeka, Kansas 66620

1. Location of well:	County	Fraction	Section number	Township number	Range number	
	Gray	NW 1/4 NW 1/4 SW 1/4	30	T 26	S R 29 <i>xx</i>	
2. Distance and direction from nearest town or city:	5 miles south of Ingalls and 1/4 miles west and 1/2 miles north		3. Owner of well:	J. E. Jury		
Street address of well location if in city:			R.R. or street:			
4. Locate with "X" in section below:	Sketch map:		6. Bore hole dia. 8 in. Completion date 3-19-77 Well depth 225 ft.			
			7. <input checked="" type="checkbox"/> Cable tool <input checked="" type="checkbox"/> Rotary <input type="checkbox"/> Driven <input type="checkbox"/> Dug <input type="checkbox"/> Hollow rod <input type="checkbox"/> Jetted <input type="checkbox"/> Bored <input type="checkbox"/> Reverse rotary	8. Use: <input checked="" type="checkbox"/> Domestic <input type="checkbox"/> Public supply <input type="checkbox"/> Industry <input type="checkbox"/> Irrigation <input type="checkbox"/> Air conditioning <input type="checkbox"/> Stock <input type="checkbox"/> Lawn <input type="checkbox"/> Oil field water <input type="checkbox"/> Other		
5. Type and color of material	From	To	9. Casing: Material RMP <input type="checkbox"/> Threaded <input type="checkbox"/> Welded <input type="checkbox"/> Surface 12 in. RMP <input checked="" type="checkbox"/> PVC <input type="checkbox"/> Weight lbs./ft. Dia. 5 in. to 225 ft. depth Wall thickness inches or Dia. <input type="checkbox"/> in. to <input type="checkbox"/> ft. depth gage No. 250	10. Screen: Manufacturer's name Sunflower Type RMP <input type="checkbox"/> Dia. 5" <input type="checkbox"/> 1/8" <input type="checkbox"/> 20 ft. Slot/gauge <input type="checkbox"/> 200 ft. and <input type="checkbox"/> 220 ft. Set between <input type="checkbox"/> ft. and <input type="checkbox"/> ft. Gravel pack? <input checked="" type="checkbox"/> Yes Size range of material <input type="checkbox"/> "		
Top soil & clay, fine sand	0	15	11. Static water level: 68 ft. below land surface Date 3-19-77	12. Pumping level below land surfaces: 70 ft. after 1 hrs. pumping 40 g.p.m. <input type="checkbox"/> ft. after <input type="checkbox"/> hrs. pumping <input type="checkbox"/> g.p.m. Estimated maximum yield 70 g.p.m.		
Fine sand & clay	15	30	13. Water sample submitted: <input type="checkbox"/> Yes <input checked="" type="checkbox"/> No Date	14. Well head completion: <input checked="" type="checkbox"/> Pitless adapter 12 inches above grade		
Fine sand	30	45	15. Well grouted? <input checked="" type="checkbox"/> Yes With: <input checked="" type="checkbox"/> Neat cement <input type="checkbox"/> Bentonite <input type="checkbox"/> Concrete Depth: From 7 ft. to 20 ft.	16. Nearest source of possible contamination: ft. 75 Direction SW Type Sewer Well disinfected upon completion? <input checked="" type="checkbox"/> Yes <input type="checkbox"/> No		
Medium to coarse sand	45	60	17. Pump: <input type="checkbox"/> Not installed Manufacturer's name Goulds Model number 13EM <input type="checkbox"/> HP 1 <input type="checkbox"/> Volts 230 Length of drop pipe 117 ft. capacity 13 g.p.m. Type: <input checked="" type="checkbox"/> Submersible <input type="checkbox"/> Turbine <input type="checkbox"/> Jet <input type="checkbox"/> Reciprocating <input type="checkbox"/> Centrifugal <input type="checkbox"/> Other	18. Elevation: 19. Remarks: Topography: <input checked="" type="checkbox"/> Hill <input type="checkbox"/> Slope <input type="checkbox"/> Upland <input type="checkbox"/> Valley		
(Use a second sheet if needed)			20. Water well contractor's certification: This well was drilled under my jurisdiction and this report is true to the best of my knowledge and belief. Joe's Well Service 179 Business name <input type="checkbox"/> License No. Address Box 174 Cimarron, Kansas Signed <i>Larry Creek</i> Date 4-15-77 Authorized representative			