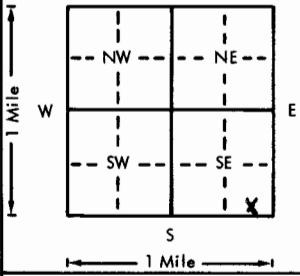


USE TYPEWRITER OR BALL
POINT PEN-PRESS FIRMLY,
PRINT CLEARLY.

WATER WELL RECORD
KSA 82a-1201-1215

Kansas Department of Health and
Environment-Division of Environment
(Water well Contractors)
Topeka, Kansas 66620

1. Location of well:	County Gray	Fraction SE 1/4 SE 1/4 SE 1/4	Section number 33	Township number T 26	Range number S R 29 E 1/4
2. Distance and direction from nearest town or city:	6 Miles S, 1 mile west of Ingalls, Kansas		3. Owner of well: R.R. or street: City, state, zip code:	Dave Minet 1307 Ave. B Dodge City, Kansas	
4. Locate with "X" in section below:	Sketch map: 		6. Bore hole dia. 28 in. Completion date 10-25-76 Well depth 222 ft.		
5. Type and color of material	From 0	To 2	7. <input type="checkbox"/> Cable tool <input type="checkbox"/> Rotary <input type="checkbox"/> Driven <input type="checkbox"/> Dug <input type="checkbox"/> Hollow rod <input type="checkbox"/> Jetted <input type="checkbox"/> Bored <input checked="" type="checkbox"/> Reverse rotary	8. Use: <input type="checkbox"/> Domestic <input type="checkbox"/> Public supply <input type="checkbox"/> Industry <input checked="" type="checkbox"/> Irrigation <input type="checkbox"/> Air conditioning <input type="checkbox"/> Stock <input type="checkbox"/> Lawn <input type="checkbox"/> Oil field water <input type="checkbox"/> Other	
Fine sand	2	75	9. Casing: Material Stl Height: Above or below Threaded <input type="checkbox"/> Welded <input checked="" type="checkbox"/> Surface T2 in. RMP 37 lbs./ft.	10. Screen: Manufacturer's name Foster, Cook , Type MISIOT, WW, louver Dia. 16" Slot/gauze i/8" Length 141' Set between 81 ft. and 222 ft. ft. and 4.4 ft. Gravel pack? <input checked="" type="checkbox"/> Size range of material 4.4 mm	
Fine to coarse sand with tan clay streaks	75	135	11. Static water level: 96 ft. below land surface Date 4-3-76	12. Pumping level below land surfaces: 106 ft. after 1 hrs. pumping 806 g.p.m. 119 ft. after 1 hrs. pumping 1284 g.p.m. Estimated maximum yield 2000 g.p.m.	
Fine to coarse sand medium gravel	135	145	13. Water sample submitted: Yes <input checked="" type="checkbox"/> No Date	14. Well head completion: <input type="checkbox"/> Pitless adapter <input checked="" type="checkbox"/> Inches above grade	
Coarse sand with tan clay	145	162	15. Well grouted? yes	With: <input type="checkbox"/> Neat cement <input checked="" type="checkbox"/> Bentonite <input type="checkbox"/> Concrete Depth: From 0 ft. to 10 ft.	
Tan and green clay	162	179	16. Nearest source of possible contamination: unk	17. Pump: Manufacturer's name U.S. Not installed Model number 12" HP 1 Volts 110 Length of drop pipe 180 ft. capacity g.p.m. Type: <input type="checkbox"/> Submersible <input checked="" type="checkbox"/> Turbine <input type="checkbox"/> Jet <input type="checkbox"/> Reciprocating <input type="checkbox"/> Centrifugal <input type="checkbox"/> Other	
Coarse sand medium gravel	179	182	18. Elevation:	19. Remarks: (Use a second sheet if needed)	
Yellow clay	182	222	20. Water well contractor's certification: This well was drilled under my jurisdiction and this report is true to the best of my knowledge and belief.		
Black shale	222	230	Layne-Western Co., Inc. 102		
			Business name Garden City, Kansas License No.		
Topography: <input type="checkbox"/> Hill <input type="checkbox"/> Slope <input checked="" type="checkbox"/> Upland <input type="checkbox"/> Valley			Address Garden City, Kansas		
			Signed President Authorized representative John Layne Date 8/26/76		