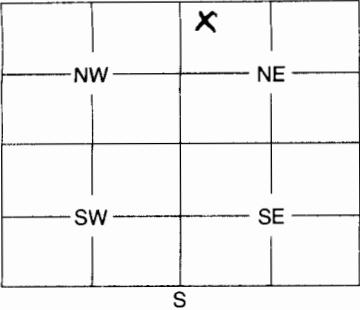


1	LOCATION OF WATER WELL:	Fraction NW $\frac{1}{4}$ NW $\frac{1}{4}$ NE $\frac{1}{4}$	Section Number 32	Township Number 26	Range Number 19
County: Gray Distance and direction from nearest town or city street address of well if located within city? from Isgalis, 5 miles south on 11rd., then 2 3/8 miles west.					
2	WATER WELL OWNER: RR #, St. Address, Box #: City, State, ZIP Code :	Joe Jury 17504 7rd. Inga 115, KS. 67853 Board of Agriculture, Division of Water Resources Application Number:			
3	MARK WELL'S LOCATION WITH AN "X" IN SECTION BOX: 	4	DEPTH OF WELL 86 ft.		
			WELL'S STATIC WATER LEVEL ft.		
			WELL WAS USED AS:		
			<input checked="" type="checkbox"/> Domestic 2 Irrigation 3 Feedlot 4 Industrial	5 Public Water Supply 6 Oil Field Water Supply 7 Domestic (Lawn & Garden) 8 Air Conditioning	9 Dewatering 10 Monitoring Well 11 Injection Well 12 Other
Was a chemical / bacteriological sample submitted to Department? Yes No <input checked="" type="checkbox"/> If yes, mo/day/yr sample was submitted					
Water Well Disinfected: Yes No					
5	TYPE OF BLANK CASING USED:				
1 Steel 3 RMP (SR) 5 Wrought 7 Fiberglass 9 Other (Specify below) <u>Styrene</u> 2 PVC 4 ABS 6 Asbestos-Cement 8 Concrete Tile					
Blank casing diameter <u>5</u> in. Was casing pulled? Yes No <input checked="" type="checkbox"/> If yes, how much					
Casing height above or <u>below</u> land surface <u>36</u> in.					
6	GROUT PLUG MATERIAL: 1 Neat cement 2 Cement grout <input checked="" type="checkbox"/> Bentonite 4 Other				
Grout Plug Intervals: From <u>3</u> ft. to <u>23</u> ft., From ft. to ft., From to ft.					
What is the nearest source of possible contamination:					
1 Septic tank 2 Sewer lines 3 Watertight sewer lines 4 Lateral lines 5 Cess pool			6 Seepage pit 7 Pit privy 8 Sewage lagoon 9 Feedyard 10 Livestock pens 11 Fuel storage 12 Fertilizer storage 13 Insecticide storage <input checked="" type="checkbox"/> Abandoned water well 15 Oil well/Gas well		
16 Other (specify below)					
Direction from well? <u>South</u> How many feet? <u>30</u>					
FROM	TO	PLUGGING MATERIALS			
<u>3</u>	<u>23</u>	<u>Bentonite chips</u>			
<u>23</u>	<u>86</u>	<u>Compacted clays</u>			
INSTRUCTIONS: Use typewriter or ball point pen. Please press firmly and print clearly. Please fill in blanks, underline or circle the correct answers. Send top three copies to Kansas Department of Health and Environment, Bureau of Water, Geology Section, 1000 SW Jackson St., Ste. 420, Topeka, Kansas 66612-1367. Telephone: 785/296-5522. Send one to Water Well Owner and retain one for your records.					
7	CONTRACTOR'S OF LANDOWNER'S CERTIFICATION: This water well was plugged under my jurisdiction and was completed on (mo/day/year) <u>3/29/12</u> and this record is true to the best of my knowledge and belief. Kansas Water Well Contractor's License No. <u>533</u> This Water Well Record was completed on (mo/day/year) <u>3/29/12</u> under the business name of <u>Tentacor Water Well</u> by (signature) <u>J. L. Jeff</u>				