


WATER WELL RECORD

Form WWC-5

Division of Water Resources App. No.

1 LOCATION OF WATER WELL:
 County: Gray Fraction NE 1/4 SE 1/4 SE 1/4 NE 1/4 Section Number 27 Township No. T 26 S Range Number R 29 E W
 Street/Rural Address of Well Location; if unknown, distance & direction from nearest town or intersection: If at owner's address, check here **Global Positioning System (GPS) information:**
 Latitude: (in decimal degrees)
 Longitude: (in decimal degrees)
 Elevation:
 Datum: WGS 84, NAD 83, NAD 27
 Collection Method:
 GPS unit (Make/Model:)
 Digital Map/Photo, Topographic Map, Land Survey
 Est. Accuracy: <3 m, 3-5 m, 5-15 m, >15 m

2 WATER WELL OWNER: Darren Batman
 RR#: Street Address, Box #: 17503 11rd.
 City, State, ZIP Code: Ingalls, Ks. 67853

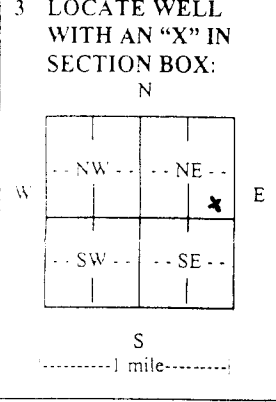

4 DEPTH OF COMPLETED WELL 485 ft.
 Depth(s) Groundwater Encountered (1) ft. (2) ft. (3) ft.
 WELL'S STATIC WATER LEVEL 266 ft. below land surface measured on mo/day/yr. 8/18/15
 Pump test data: Well water was ft. after hours pumping gpm
 EST. YIELD gpm Well water was ft. after hours pumping gpm
 Bore Hole Diameter 9 7/8 in. to 4 8/5 ft., and in. to ft.
 WELL WATER TO BE USED AS: Public water supply Geothermal Injection well
 Domestic Feedlot Oil field water supply Dewatering Other (Specify below)
 Irrigation Industrial Domestic-lawn & garden Monitoring well
 Was a chemical/bacteriological sample submitted to Department? Yes No
 If yes, mo/day/yr sample was submitted.....
 Water well disinfected? Yes No

5 TYPE OF CASING USED: Steel PVC Other
 CASING JOINTS: Glued Clamped Welded Threaded
 Casing diameter 5 in. to 4 8/5 ft., Diameter in. to ft., Diameter in. to ft.
 Casing height above land surface 12 in., Weight lbs./ft., Wall thickness or gauge No. SOR 21

TYPE OF SCREEN OR PERFORATION MATERIAL:
 Steel Stainless Steel PVC Other (Specify)
 Brass Galvanized Steel None used (open hole)
SCREEN OR PERFORATION OPENINGS ARE:
 Continuous slot Mill slot Gauze wrapped Torch cut Drilled holes None (open hole)
 Louvered shutter Key punched Wire wrapped Saw cut Other (specify)
SCREEN-PERFORATED INTERVALS: From 385 ft. to 485 ft., From ft. to ft.
GRAVEL PACK INTERVALS: From 24 ft. to 310 ft., From 320 ft. to 485 ft.
 From ft. to ft., From ft. to ft.

6 GROUT MATERIAL: Neat cement Cement grout Bentonite Other
 Grout Intervals: From 4 ft. to 24 ft., From 310 ft. to 350 ft., From ft. to ft.
 What is the nearest source of possible contamination:
 Septic tank Lateral lines Pit privy Livestock pens Insecticide storage Other (specify below)
 Sewer lines Cesspool Sewage lagoon Fuel storage Abandoned water well
 Watertight sewer lines Seepage pit Feedyard Fertilizer storage Oil well/gas well
 Direction from well East Distance from well 30

FROM	TO	LITHOLOGIC LOG	FROM	TO	LITHO. LOG (cont.) or PLUGGING INTERVALS
0	60	Brown sandy clay	256	310	Shale
60	80	Tan sandy & Caliche	310	321	Shale + Sandstone
80	120	Med. sand	321	380	Sandstone (tight)
120	200	Course sand	330	385	Sandstone (loose)
200	220	Med. sand	385	395	Shale + sandstone
220	240	Med. - course sand	395	400	Sandstone (loose)
240	242	Brown clay	400	465	Sandstone & shale layers
242	250	Sandstone	465	468	Sandstone (loose)
250	255	Shale	468	480	Shale + Sandstone
255	256	limestone			

7 CONTRACTOR'S OR LANDOWNER'S CERTIFICATION: This water well was constructed, reconstructed, or plugged under my jurisdiction and was completed on (mo/day/year) 8/18/15 and this record is true to the best of my knowledge and belief. Kansas Water Well Contractor's License No. 533 This Water Well Record was completed on (mo/day/year) 12/16/15 under the business name of Jantzen Water Well by (signature) [Signature]

INSTRUCTIONS: Use typewriter or ball point pen. PLEASE PRESS FIRMLY and PRINT clearly. Please fill in blanks and check the correct answers. Send three copies (white, blue, pink) to Kansas Department of Health and Environment, Bureau of Water, Geology Section, 1000 SW Jackson St., Suite 420, Topeka, Kansas 66612-1367. Telephone 785-296-5524. Send one copy to WATER WELL OWNER and retain one for your records. Include fee of \$5.00 for each constructed well. Visit us at <http://www.kdheks.gov/waterwell/index.html>.