WATER WELL RECORD Form WWC-5 KSA 82a-1212

1 LOCATION OF WATER WELL:	Fraction	Section Number	Township Number	Range Number
County: Sedgwick	SE ¼ SE ¼ SE ¼	10	T 26 S	R 3 E/W

Distance and direction from nearest town or city street address of well if located within city?
501 Andale Road, Andale, KS

2 WATER WELL OWNER: James Molitar
RR#, St. Address, Box # : P.O. Box 156
City, State, ZIP Code : Andale, KS Well # MW-15

Board of Agriculture, Division of Water Resources
Application Number:

3 LOCATE WELL'S LOCATION WITH AN "X" IN SECTION BOX:

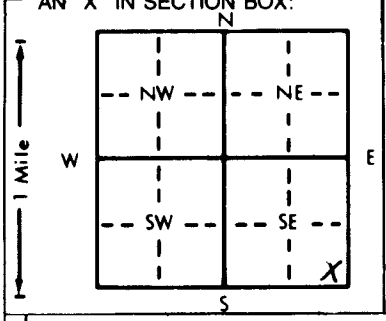

4 DEPTH OF COMPLETED WELL 35 ft. ELEVATION: 1426.22
Depth(s) Groundwater Encountered 1. 23 ft. 2. ft. 3. ft.
WELL'S STATIC WATER LEVEL 25.09 ft. below land surface measured on mo/day/yr 5/15/95
Pump test data: Well water was ft. after hours pumping gpm
Est. Yield gpm: Well water was ft. after hours pumping gpm
Bore Hole Diameter 8 in. to 35 ft., and in. to ft.
WELL WATER TO BE USED AS: 5 Public water supply 8 Air conditioning 11 Injection well
1 Domestic 3 Feedlot 6 Oil field water supply 9 Dewatering 12 Other (Specify below)
2 Irrigation 4 Industrial 7 Lawn and garden only (10) Monitoring well
Was a chemical/bacteriological sample submitted to Department? Yes ; (No); If yes, mo/day/yr sample was submitted
Water Well Disinfected? Yes (No)

5 TYPE OF BLANK CASING USED: 5 Wrought iron 8 Concrete tile CASING JOINTS: Glued Clamped
1 Steel 3 RMP (SR) 6 Asbestos-Cement 9 Other (specify below) Welded
(2) PVC 4 ABS 7 Fiberglass (Threaded)
Blank casing diameter 2 in. to 20 ft., Dia in. to ft., Dia in. to ft.
Casing height above land surface -5 in., weight lbs./ft. Wall thickness or gauge No. SCH. 40
TYPE OF SCREEN OR PERFORATION MATERIAL: (7) PVC 10 Asbestos-cement
1 Steel 3 Stainless steel 5 Fiberglass 8 RMP (SR) 11 Other (specify)
2 Brass 4 Galvanized steel 6 Concrete tile 9 ABS 12 None used (open hole)
SCREEN OR PERFORATION OPENINGS ARE: 5 Gauzed wrapped (8) Saw cut 11 None (open hole)
1 Continuous slot 3 Mill slot 6 Wire wrapped 9 Drilled holes
2 Louvered shutter 4 Key punched 7 Torch cut 10 Other (specify)
SCREEN-PERFORATED INTERVALS: From 20 ft. to 35 ft., From ft. to ft.
From ft. to ft., From ft. to ft.
GRAVEL PACK INTERVALS: From 20 ft. to 35 ft., From ft. to ft.
From ft. to ft., From ft. to ft.

6 GROUT MATERIAL: 1 Neat cement 2 Cement grout (3) Bentonite 4 Other
Grout Intervals: From 1 ft. to 20 ft., From ft. to ft., From ft. to ft.
What is the nearest source of possible contamination: 10 Livestock pens 14 Abandoned water well
1 Septic tank 4 Lateral lines 7 Pit privy (11) Fuel storage 15 Oil well/Gas well
2 Sewer lines 5 Cess pool 8 Sewage lagoon 12 Fertilizer storage 16 Other (specify below)
3 Watertight sewer lines 6 Seepage pit 9 Feedyard 13 Insecticide storage
Direction ~~East~~ Northeast How many feet? 110

FROM	TO	LITHOLOGIC LOG	FROM	TO	PLUGGING INTERVALS
0	1	Concrete			
1	2	Sand and gravel fill			
2	9	Brown silty clay			
9	19	Red-brown silty clay			
19	35	Red-brown silty clay			

7 CONTRACTOR'S OR LANDOWNER'S CERTIFICATION: This water well was (1) constructed, (2) reconstructed, or (3) plugged under my jurisdiction and was completed on (mo/day/year) 3/23/95 and this record is true to the best of my knowledge and belief. Kansas Water Well Contractor's License No. 534 This Water Well Record was completed on (mo/day/yr) 3/12/96
under the business name of PSI by (signature) [signature]

INSTRUCTIONS: Use typewriter or ball point pen. *PLEASE PRESS FIRMLY* and *PRINT* clearly. Please fill in blanks, underline or circle the correct answers. Send top three copies to Kansas Department of Health and Environment, Bureau of Water, Topeka, Kansas 66620-0001. Telephone: 913-296-5545. Send one to WATER WELL OWNER and retain one for your records.

OFFICE USE ONLY T R E/W SEC. ¼ ¼ ¼