Plugging MW-11

WATER WELL PLUGGING RECORD Form WWC-5P KSA 82a-1212 ID NO. no tag - no StateID Form

1 LOCATION OF WATER WELL:	Fraction	Section Number	Township Number	Range Number
County: Sedgwick	SW ¼ NE¼ NE¼	15	25 S	3 W

Distance and direction from nearest town or city street address of well if located within city?
248 S Main

2 WATER WELL OWNER: Sedgwick Co. Andale Yard
RR #, St. Address, Box #: 248 S Main
City, State, ZIP Code : Andale KS
Board of Agriculture, Division of Water Resources
Application Number:

3 MARK WELL'S LOCATION WITH AN "X" IN SECTION BOX:

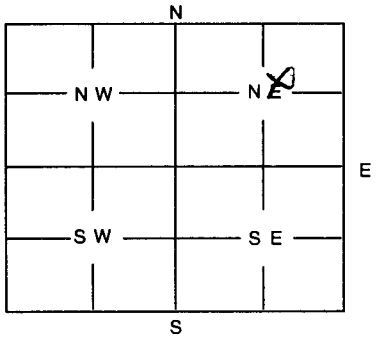

4 DEPTH OF WELL 58 ft
WELL'S STATIC WATER LEVEL 42.22 ft.

WELL WAS USED AS:

1 Domestic	5 Public Water Supply	9 Dewatering
2 Irrigation	6 Oil Field Water Supply	(10) Monitoring Well MW-11
3 Feedlot	7 Domestic (Lawn & Garden)	11 Injection Well
4 Industrial	8 Air Conditioning	12 Other

Was a chemical / bacteriological sample submitted to Department? Yes ..... No ✓
If yes, mo/day/yr sample was submitted .....

Water Well Disinfected: Yes ..... No ✓

5 TYPE OF BLANK CASING USED:

1 Steel	3 RMP (SR)	5 Wrought	7 Fiberglass	9 Other (Specify below)
(2) PVC	4 ABS	6 Asbestos-Cement	8 Concrete Tile	

Blank casing diameter 4 in. Was casing pulled? Yes ✓ No ..... If yes, how much 3ft 6y dig out
Casing height above or below land surface +.5 in.

6 GROUT PLUG MATERIAL: 1 Neat cement 2 Cement grout (3) Bentonite 4 Other .....

Grout Plug Intervals: From 3 ft. to 42.22 ft., From ..... ft. to ..... ft., From ..... to ..... ft.

What is the nearest source of possible contamination:

1 Septic tank	6 Seepage pit	11 Fuel storage	(16) Other (specify below)
2 Sewer lines	7 Pit privy	12 Fertilizer storage	Contaminated soil
3 Watertight sewer lines	8 Sewage lagoon	13 Insecticide storage	
4 Lateral lines	9 Feedyard	14 Abandoned water well	
5 Cess Pool	10 Livestock pens	15 Oil well/Gas well	

Direction from well? ..... How many feet? .....

FROM	TO	PLUGGING MATERIALS
0	3	surface soils, dug
3	42.22	bentonite
42.22	58	Chloride sand

7 CONTRACTOR'S OR LANDOWNER'S CERTIFICATION: This water well was plugged under my jurisdiction and was completed on (mo/day/year) 11/13/07 and this record is true to the best of my knowledge and belief. Kansas Water Well Contractor's License No. 585 This Water Well Record was completed on (mo/day/year) 11/27/07 under the business name of AEI by (signature) A Duncan for D Dunca

INSTRUCTIONS: Use typewriter or ball point pen. Please press firmly and print clearly. Please fill in blanks, underline or circle the correct answers. Send top three copies to Kansas Department of Health and Environment, Bureau of Water, Topeka, Kansas 66620-0001. Telephone: 785/296-3565. Send one to Water Well Owner and retain one for your records.