


1	LOCATION OF WATER WELL	Fraction	Section Number	Township Number	Range Number

Distance and direction from nearest town or city street address of well if located within city?

2 WATER WELL OWNER: Tim Freund
RR#, St. Address, Box # : 126 So 5th
City, State, ZIP Code : Colwich KS 67030

Board of Agriculture, Division of Water Resources
Application Number:

3 LOCATE WELL'S LOCATION WITH AN "X" IN SECTION BOX: 4 DEPTH OF COMPLETED WELL..... 66.35 ft. ELEVATION:

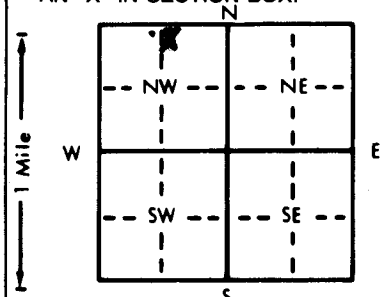

4 DEPTH OF COMPLETED WELL..... 66 ft. ELEVATION:

Depth(s) Groundwater Encountered 1. 35 ft. 2. ft. 3. ft.

WELL'S STATIC WATER LEVEL 35 ft. below land surface measured on mo/day/yr 7-7-86

Pump test data: Well water was 37 ft. after 1/2 hours pumping 20 gpm

Est. Yield 20-30 gpm: Well water was ft. after hours pumping gpm

Bore Hole Diameter. 1 1/2 in. to 66 ft., and in. to ft.

WELL WATER TO BE USED AS:

5 Public water supply	8 Air conditioning	11 Injection well		
<u>1</u> Domestic	3 Feedlot	6 Oil field water supply	9 Dewatering	12 Other (Specify below)
2 Irrigation	4 Industrial	7 Lawn and garden only	10 Observation well	

Was a chemical/bacteriological sample submitted to Department? Yes..... No..... X If yes, mo/day/yr sample was submitted.....

Water Well Disinfected? Yes X No.....

5 TYPE OF BLANK CASING USED: 5 Wrought iron 8 Concrete tile CASING JOINTS: Glued ☒ Clamped ☐
1 Steel 3 RMP (SR) 6 Asbestos-Cement 9 Other (specify below) Welded ☐
2 PVC 4 ABS 7 Fiberglass Threaded ☐
Blank casing diameter 5 in. to 40 ft., Dia. in. to ft., Dia. in. to ft.
Casing height above land surface 12 in., weight 1.59 lbs./ft. Wall thickness or gauge No. SR-26

TYPE OF SCREEN OR PERFORATION MATERIAL:

1 Steel	3 Stainless steel	5 Fiberglass	7 PVC	10 Asbestos-cement
2 Brass	4 Galvanized steel	6 Concrete tile	8 RMP (SR)	11 Other (specify)
			9 ABS	12 None used (open hole)

SCREEN OR PERFORATION OPENINGS ARE:

1 Continuous slot	3 Mill slot	5 Gauzed wrapped	8 Saw cut	11 None (open hole)
2 Louvered shutter	4 Key punched	6 Wire wrapped	9 Drilled holes	
		7 Torch cut	10 Other (specify)	

SCREEN-PERFORATED INTERVALS:	From . . . 40 . . .	ft. to . . . 66 . . .	ft., From . . .	ft. to . . .	ft.
	From . . .	ft. to . . .	ft., From . . .	ft. to . . .	ft.
GRAVEL PACK INTERVALS:	From . . . 15 . . .	ft. to . . . 66 . . .	ft., From . . .	ft. to . . .	ft.
	From . . .	ft. to . . .	ft., From . . .	ft. to . . .	ft.

6 GROUT MATERIAL: 1 Neat cement 2 Cement grout 3 Bentonite 4 Other

Grout Intervals: From 0 ft. to 15 ft. From ft. to ft. From ft. to ft.

What is the nearest source of possible contamination:

1 Septic tank	4 Lateral lines	7 Pit privy	10 Livestock pens	14 Abandoned water well
2 Sewer lines	5 Cess pool	8 Sewage lagoon	11 Fuel storage	15 Oil well/Gas well
3 Watertight sewer lines	6 Seepage pit	9 Feedyard	12 Fertilizer storage	16 Other (specify below)
Direction from well? <i>North</i>			13 Insecticide storage	
How many feet? <i>15</i>				

[illegible]

7 CONTRACTOR'S OR LANDOWNER'S CERTIFICATION: This water well was (1) constructed, (2) reconstructed, or (3) plugged under my jurisdiction and was completed on (mo/day/year) 7-7-86 and this record is true to the best of my knowledge and belief. Kansas

Water Well Contractor's License No. 318 This Water Well Record was completed on (mo/day/yr) 1-7-86
under the business name of Wenger, Dolly by (signature) [Signature]

INSTRUCTIONS: Use typewriter or ball point pen. PLEASE PRESS FIRMLY and PRINT clearly. Please fill in blanks, underline or circle the correct answers. Send top three copies to Kansas Department of Health and Environment, Office of Oil Field and Environmental Geology, Regulation and Permitting Section, Topeka, Kansas 66620-7500. Telephone: 913-862-9360. Send one to WATER WELL OWNER and retain one for your records.