USE TYPEWRITER OR BALL POINT PEN-PRESS FIRMLY, PRINT CLEARLY.

WATER WELL RECORD
KSA 82a-1201-1215

Kansas Department of Health and Environment-Division of Environment
(Water well Contractors)
Topeka, Kansas 66620

1. Location of well:	County: Sedg.	Fraction: SW 1/4 SE 1/4 SE 1/4	Section number: 10	Township number: T 26 S	Range number: R 3 E (W)

2. Distance and direction from nearest town or city:
Street address of well location if in city: 601 Countryside Andale Ks

3. Owner of well: Mike Stanhope
R.R. or street: 105 magnolia
City, state, zip code: andale Ks. 67001

4. Locate with "X" in section below:

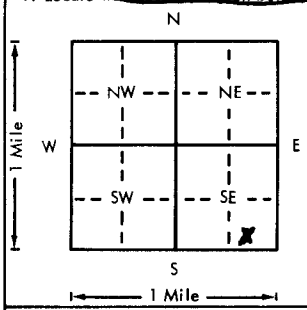

Sketch map:

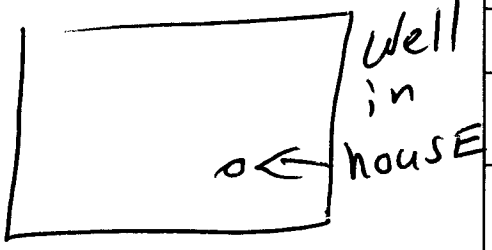

6. Bore hole dia. 11 in. Completion date
Well depth 70 ft. 11/28/77

7. __ Cable tool X Rotary __ Driven __ Dug
__ Hollow rod __ Jetted __ Bored __ Reverse rotary

8. Use: X Domestic __ Public supply __ Industry
__ Irrigation __ Air conditioning __ Stock
__ Lawn __ Oil field water __ Other

9. Casing: Material PVC Height Above or below
Threaded ___ Welded X Surface 12 in.
RMP ___ PVC X Weight 2.37 lbs./ft.
Dia. 5 in. to 70 ft. depth Wall Thickness: inches or
Dia. ___ in. to ___ ft. depth gage No. 214

10. Screen: Manufacturer's name M.P.I.
Type PVC Dia. 5 in
Slot/gauze 116 Length 10 ft.
Set between 60 ft. and 70 ft.
___ ft. and ___ ft.
Gravel pack? yes Size range of material 3/8

11. Static water level: mo./day/yr.
35 ft. below land surface Date 11/28/77

12. Pumping level below land surfaces:
38 ft. after 1/2 hrs. pumping 15 g.p.m.
___ ft. after ___ hrs. pumping ___ g.p.m.
Estimated maximum yield 100 g.p.m.

13. Water sample submitted: mo./day/yr.
__ Yes X No Date

14. Well head completion:
__ Pitless adapter 12 inches above grade

15. Well grouted? yes
With: __ Neat cement __ Bentonite X Concrete
Depth: From 6 ft. to 16 ft.

16. Nearest source of possible contamination:
ft. ___ Direction NONE Type
Well disinfected upon completion? X Yes __ No

17. Pump: X Not installed
Manufacturer's name
Model number ___ HP ___ Volts ___
Length of drop pipe ___ ft. capacity ___ g.p.m.
Type:
__ Submersible __ Turbine
__ Jet __ Reciprocating
__ Centrifugal __ Other

5. Type and color of material

Type and color of material	From	To
Top Soil	0	4
Red clay.	4	47
fine to med. sand.	47	63
blue green shale.	63	70

(Use a second sheet if needed)

18. Elevation:

Topography:
__ Hill
__ Slope
X Upland
__ Valley

19. Remarks:

20. Water well contractor's certification:
This well was drilled under my jurisdiction and this report is true to the best of my knowledge and belief.
Wenninger Drilling 318
Business name License No.
Address Sedgwick
Signed Authorized representative Date 12/28/77

Forward the white, blue and pink copies to the Department of Health and Environment

Form WWC-5

T 26 R 3 (W) Sec 10 SE SE SE 1/4 1/4 1/4

MI-1023