

1 LOCATION OF WATER WELL: Fraction SW 1/4 SE 1/4 SE 1/4 Section Number 10 Township Number T 26 S Range Number R 3 W
 Distance and direction from nearest town or city street address of well if located within city?

2 WATER WELL OWNER:

RR#, St. Address, Box # :

City, State, ZIP Code :


See Below
BART REICHENBERGER
503 Country Side
Andale KS 67001

Board of Agriculture, Division of Water Resources

Application Number:

3 LOCATE WELL'S LOCATION WITH AN "X" IN SECTION BOX:

4 DEPTH OF COMPLETED WELL: 73 ft. ELEVATION:

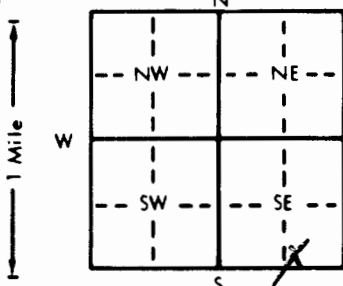

Depth(s) Groundwater Encountered 1. 49 ft. 2. 50 ft. 3. 6-10-89 ft.

WELL'S STATIC WATER LEVEL 46 ft. below land surface measured on mo/day/yr 6-10-89

Pump test data: Well water was 50 ft. after 1/2 hours pumping 20 gpm

Est. Yield 50 gpm: Well water was 50 ft. after 1/2 hours pumping 20 gpm

Bore Hole Diameter 1 1/2 in. to 73 ft., and 73 in. to 73 ft.

WELL WATER TO BE USED AS: 5 Public water supply 8 Air conditioning 11 Injection well

1 Domestic 3 Feedlot 6 Oil field water supply 9 Dewatering 12 Other (Specify below)

2 Irrigation 4 Industrial 7 Lawn and garden only 10 Monitoring well

Was a chemical/bacteriological sample submitted to Department? Yes X No X If yes, mo/day/yr sample was sub-

mitted Water Well Disinfected? Yes X No X

5 TYPE OF BLANK CASING USED:

1 Steel 3 RMP (SR)

2 PVC 4 ABS

Blank casing diameter 5 in. to 57 ft., Dia 57 in. to 57 ft., Dia 57 in. to 57 ft.

Casing height above land surface 12 in., weight 1.59 lbs./ft. Wall thickness or gauge No 50R26

TYPE OF SCREEN OR PERFORATION MATERIAL:

1 Steel 3 Stainless steel

2 Brass 4 Galvanized steel

5 Fiberglass 8 RMP (SR)

6 Concrete tile 9 ABS

7 PVC 10 Asbestos-cement

11 Other (specify) 12 None used (open hole)

SCREEN OR PERFORATION OPENINGS ARE:

1 Continuous slot 3 Mill slot

2 Louvered shutter 4 Key punched

5 Gauzed wrapped 8 Saw cut 11 None (open hole)

6 Wire wrapped 9 Drilled holes

7 Torch cut 10 Other (specify)

SCREEN-PERFORATED INTERVALS:

From 57 ft. to 73 ft., From 57 ft. to 73 ft., From 57 ft. to 73 ft.

GRAVEL PACK INTERVALS: From 30 ft. to 73 ft., From 30 ft. to 73 ft., From 30 ft. to 73 ft.

6 GROUT MATERIAL:

1 Neat cement

2 Cement grout

3 Bentonite

4 Other

Grout Intervals: From 3 ft. to 30 ft., From 30 ft. to 73 ft., From 30 ft. to 73 ft.

What is the nearest source of possible contamination:

1 Septic tank 4 Lateral lines

2 Sewer lines 5 Cess pool

3 Watertight sewer lines 6 Seepage pit

7 Pit privy 8 Sewage lagoon

9 Feedyard 10 Livestock pens

11 Fuel storage 15 Oil well/Gas well

12 Fertilizer storage 16 Other (specify below)

13 Insecticide storage

Direction from well?

West

How many feet? 30

FROM	TO	LITHOLOGIC LOG	FROM	TO	PLUGGING INTERVALS
<u>0</u>	<u>2</u>	<u>Top soil</u>			
<u>2</u>	<u>49</u>	<u>clay</u>			
<u>49</u>	<u>73</u>	<u>fine to med sand</u>			

7 CONTRACTOR'S OR LANDOWNER'S CERTIFICATION: This water well was (1) constructed (2) reconstructed, or (3) plugged under my jurisdiction and was

completed on (mo/day/year) 6-10-89 and this record is true to the best of my knowledge and belief. Kansas

Water Well Contractor's License No. 318 This Water Well Record was completed on (mo/day/yr) 6-22-89

under the business name of Weninger Pully by (signature) [Signature]