USE TYPEWRITER OR BALL POINT PEN-PRESS FIRMLY, PRINT CLEARLY.

WATER WELL RECORD
KSA 82a-1201-1215

Kansas Department of Health and Environment-Division of Environment
(Water well Contractors)
Topeka, Kansas 66620

1. Location of well:	County: Sedgwick.	Fraction: SE 1/4 SE 1/4 SE 1/4	Section number: 10	Township number: T 26 S	Range number: R 3 (W)

2. Distance and direction from nearest town or city: TOWN OF ANDALE
Street address of well location if in city:

3. Owner of well: Carl Borges
R.R. or street:
City, state, zip code: Andale Ks 67001

4. Locate with "X" in section below:

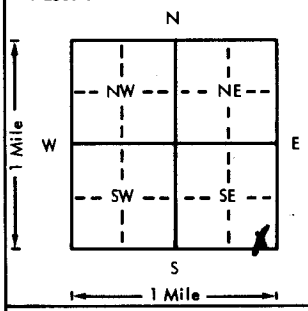

Sketch map:

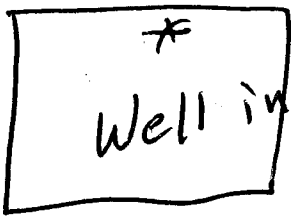

6. Bore hole dia. 10 in. Completion date
Well depth 70 ft. 8-4-76

7. __ Cable tool X Rotary __ Driven __ Dug
__ Hollow rod __ Jetted __ Bored __ Reverse rotary

8. Use: X Domestic __ Public supply __ Industry
__ Irrigation __ Air conditioning __ Stock
__ Lawn __ Oil field water __ Other

9. Casing: Material
Threaded ___ Welded ___
RMP ___ PVC X
Dia. 5 in. to 70 ft. depth
Dia. ___ in. to ___ ft. depth
Height: Above or below Surface 12 in.
Weight 160 lbs./ft.
Wall Thickness: inches or gage No. 125 214

10. Screen: Manufacturer's name ~~Bumpco~~ MPI
Type PVC Dia. 5 in.
Slot gauze 4/16 Length 5 ft.
Set between 65 ft. and 70 ft.
___ ft. and ___ ft.
Gravel pack? Yes Size range of material 3/8

11. Static water level: mo./day/yr.
24 ft. below land surface Date 8-4-76

12. Pumping level below land surfaces:
35 ft. after 1 hrs. pumping 20 g.p.m.
___ ft. after ___ hrs. pumping ___ g.p.m.
Estimated maximum yield 75 g.p.m.

13. Water sample submitted: mo./day/yr.
__ Yes X No Date

14. Well head completion:
__ Pitless adapter 12 Inches above grade

15. Well grouted? Yes.
With: X Neat cement ___ Bentonite ___ Concrete
Depth: From 8 ft. to 18 ft.

16. Nearest source of possible contamination:
ft. ___ Direction ___ Type
Well disinfected upon completion? X Yes ___ No

17. Pump: X Not installed
Manufacturer's name
Model number ___ HP ___ Volts ___
Length of drop pipe ___ ft. capacity ___ g.p.m.
Type:
__ Submersible __ Turbine
__ Jet __ Reciprocating
__ Centrifugal __ Other

5. Type and color of material

	From	To
Top soil	0	4
Red clay.	4	52
course gravel	52	70

(Use a second sheet if needed)

18. Elevation:
Topography:
__ Hill
__ Slope
X Upland
__ Valley

19. Remarks:

20. Water well contractor's certification:
This well was drilled under my jurisdiction and this report is true to the best of my knowledge and belief.
Business name Weninger Drl License No. 318
Address Colwich Ks
Signature Jerome Weninger Date 8-4-76
Authorized representative

T 26 S R 3 E (W) Sec 10 1/4 SE 1/4 SE 1/4 SE

Forward the white, blue and pink copies to the Department of Health and Environment

Form WWC-5

MI-1023