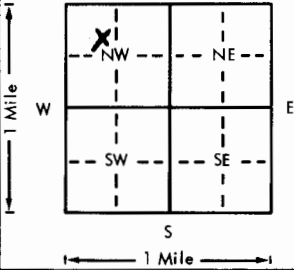
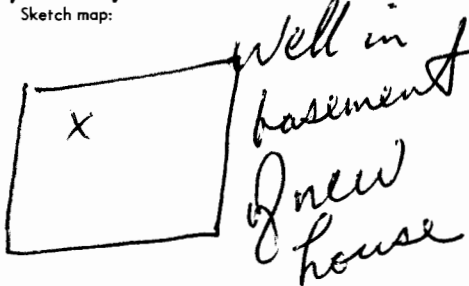


USE TYPEWRITER OR BALL
POINT PEN-PRESS FIRMLY,
PRINT CLEARLY.

WATER WELL RECORD
KSA 82a-1201-1215

Kansas Department of Health and
Environment-Division of Environment
(Water well Contractors)
Topeka, Kansas 66620

1. Location of well:		County <u>Sedgwick</u>	Fraction <u>SE 1/4 NW 1/4 NW 1/4</u>	Section number <u>14</u>	Township number <u>T 26 S</u>	Range number <u>R 3 E</u>
2. Distance and direction from nearest town or city:		3. Owner of well: <u>FRANK HORSCH</u>		R.R. or street: <u>RR 1</u>		
Street address of well location if in city: <u>302 Huntington Andale KS</u>		City, state, zip code: <u>Andale KS 67001</u>		Completion date: <u>2/23/77</u>		
4. Locate with "X" in section below		Sketch map:		6. Bore hole dia. <u>11</u> in. Completion date: <u>2/23/77</u>		
				Well depth <u>62</u> ft.		
5. Type and color of material		From		To		7. Cable tool ☒ Rotary ☐ Driven ☐ Dug
<u>Top soil</u>		<u>0</u>		<u>6</u>		☐ Hollow rod ☐ Jetted ☐ Bored ☐ Reverse rotary
<u>Red clay.</u>		<u>6</u>		<u>48</u>		8. Use: ☒ Domestic ☐ Public supply ☐ Industry
<u>med. thru coarse sand</u>		<u>48</u>		<u>66</u>		☐ Irrigation ☐ Air conditioning ☐ Stock
<u>green shale</u>		<u>66</u>		<u>67</u>		☐ Lawn ☐ Oil field water ☐ Other
						9. Casing: Material <u>PVC</u> Height: <u>Above</u> or below
						Threaded ☐ Welded ☒ Surface <u>12</u> in.
						RMP ☐ PVC ☒ Weight <u>2.75</u> lbs./ft.
						Dia. <u>5</u> in. to <u>62</u> ft. depth Wall Thickness: inches or
						Dia. <u>5</u> in. to <u>62</u> ft. depth gage No. <u>258</u>
						10. Screen: Manufacturer's name <u>M.P.I.</u>
						Type <u>PVC</u> Dia. <u>5 1/4</u> in.
						Slot gauge <u>1/16</u> Length <u>5</u> ft.
						Set between <u>57</u> ft. and <u>62</u> ft.
						Gravel pack? <u>yes</u> Size range of material <u>3/8</u>
						11. Static water level: <u>33</u> ft. below land surface Date <u>2/23/77</u>
						12. Pumping level below land surfaces: <u>35</u> ft. after <u>1/2</u> hrs. pumping <u>20</u> g.p.m.
						<u>40</u> ft. after <u>1</u> hrs. pumping <u>40</u> g.p.m.
						Estimated maximum yield <u>40</u> g.p.m.
						13. Water sample submitted: <u>yes</u> No <u>no</u> Date <u>2/23/77</u>
						14. Well head completion: <u>12</u> inches above grade
						15. Well grouted? <u>yes</u>
						With: <u>Neat cement</u> <u>Bentonite</u> ☒ Concrete
						Depth: From <u>6</u> ft. to <u>16</u> ft.
						16. Nearest source of possible contamination: <u>NONE</u>
						Well disinfected upon completion? ☒ Yes ☐ No
						17. Pump: ☒ Not installed
						Manufacturer's name <u>Wenger</u>
						Model number <u>318</u> HP <u>3</u> Volts <u>115</u>
						Length of drop pipe <u>14</u> ft. capacity <u>14</u> g.p.m.
						Type: ☐ Submersible ☐ Turbine
						☐ Jet ☐ Reciprocating
						☐ Centrifugal ☐ Other
18. Elevation:		19. Remarks:		20. Water well contractor's certification:		
Topography: ☐ Hill ☐ Slope ☒ Upland ☐ Valley				This well was drilled under my jurisdiction and this report is true to the best of my knowledge and belief.		
				Business name <u>Wenger Drilling</u> License No. <u>318</u>		
				Address <u>Colwich</u>		
				Signed <u>Jerome Wenger</u> Date <u>2/23/77</u>		
				Authorized representative		

Forward the white, blue and pink copies to the Department of Health and Environment

Form WW-5