

WATER WELL RECORD Form WWC-5 KSA 82a-1212

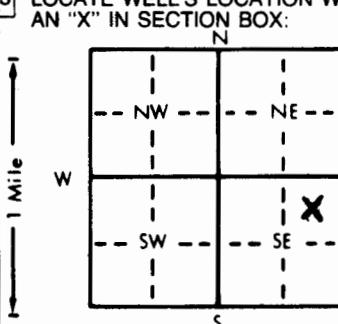
1 LOCATION OF WATER WELL:	Fraction NE <input checked="" type="checkbox"/> 1/4	NE <input type="checkbox"/> 1/4	SE <input type="checkbox"/> 1/4	Section Number 5	Township Number 26	Range Number R 30W EW
---------------------------	--	--	--	----------------------------	------------------------------	---------------------------------

County: **GRAY** Distance and direction from nearest town or city street address of well if located within city?FROM **PLYMELL SCHOOL ON HWY 83, 14 EAST, .5 NORTH & WEST INTO LOC.**2 WATER WELL OWNER: **MINTER-WILSON DRILLING COMPANY****"DAVE REYNOLDS"**

Board of Agriculture, Division of Water Resources

Application Number:

3 LOCATE WELL'S LOCATION WITHIN SECTION BOX:

4 DEPTH OF COMPLETED WELL..... **300** ft. ELEVATION:Depth(s) Groundwater Encountered 1. **150** ft. 2. ft. 3. ft.WELL'S STATIC WATER LEVEL **150** ft. below land surface measured on mo/day/yr **05-13-96**Pump test data: Well water was **170** ft. after **1** hours pumping **80** gpmEst. Yield **80** gpm: Well water was ft. after hours pumping gpmBore Hole Diameter **9 1/2** in. to ft., and in. to ft.

WELL WATER TO BE USED AS: 5 Public water supply 8 Air conditioning 11 Injection well

1 Domestic 3 Feedlot 6 Oil field water supply 9 Dewatering 12 Other (Specify below)

2 Irrigation 4 Industrial 7 Lawn and garden only 10 Monitoring well

Was a chemical/bacteriological sample submitted to Department? Yes.....No. **X**..... If yes, mo/day/yr sample was submittedWater Well Disinfected? Yes **X** No

5 TYPE OF BLANK CASING USED:

1 Steel	3 RMP (SR)
2 PVC	4 ABS

5 Wrought iron

6 Asbestos-Cement
7 Fiberglass

8 Concrete tile

9 Other (specify below)

CASING JOINTS: Glued **X** Clamped

Welded
Threaded

Blank casing diameter **5** in. to **300** ft., Dia in. to ft., Dia in. to ft.Casing height above land surface **24** in., weight **2.902** lbs./ft. Wall thickness or gauge No. **280 SDR 21**

TYPE OF SCREEN OR PERFORATION MATERIAL:

1 Steel 3 Stainless steel

5 Fiberglass

7 PVC

10 Asbestos-cement

2 Brass 4 Galvanized steel

6 Concrete tile

8 RMP (SR)

11 Other (specify)

SCREEN OR PERFORATION OPENINGS ARE:

1 Continuous slot 3 Mill slot

2 Louvered shutter 4 Key punched

SCREEN-PERFORATED INTERVALS: From **260** ft. to **300** ft., From ft. to ft.

From ft. to ft., From ft. to ft.

GRAVEL PACK INTERVALS: From **160** ft. to **300** ft., From ft. to ft.

From ft. to ft., From ft. to ft.

6 GROUT MATERIAL: **1** Neat cement

2 Cement grout

3 Bentonite

4 Other

HOLE PLUGGrout Intervals: From **0** ft. to **16** ft., From ft. to ft., From ft. to ft.

What is the nearest source of possible contamination:

1 Septic tank 4 Lateral lines

7 Pit privy

10 Livestock pens

14 Abandoned water well

2 Sewer lines 5 Cess pool

8 Sewage lagoon

11 Fuel storage

15 Oil well/Gas well

3 Watertight sewer lines 6 Seepage pit

9 Feedyard

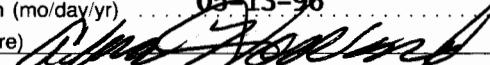
12 Fertilizer storage

16 Other (specify below)

Direction from well?

How many feet?

FROM	TO	LITHOLOGIC LOG	FROM	TO	PLUGGING INTERVALS
0	2	TOP SAND	235	240	TAN CLAY
2	16	SAND	240	257	TAN & BLUE CLAY
16	25	SAND & SANDY CLAY	257	295	COARSE SAND & SMALL GRAVEL
25	52	SANDY CLAY	295	300	CLAY
52	59	CLAY			
59	83	SANDY CLAY & SAND			
83	100	COARSE SAND			
100	110	COARSE SAND			
110	123	MED. GRAVEL			
123	160	COARSE SAND & SMALL GRAVEL			
160	184	SMALL & MED GRAVEL			
184	194	COARSE SAND & SANDY CLAY			
194	207	MED. GRAVEL			
207	225	MED GRAVEL W/CLAY STREAKS			
225	235	CLAY W/GRAVEL MTX			

7 CONTRACTOR'S OR LANDOWNER'S CERTIFICATION: This water well was **1** constructed, **2** reconstructed, or **3** plugged under my jurisdiction and was completed on (mo/day/year) **05-13-96** and this record is true to the best of my knowledge and belief. KansasWater Well Contractor's License No. **KWWCL-430** This Water Well Record was completed on (mo/day/yr) **05-13-96**under the business name of **HOWARD DRILL CO. BOX 806 BEAVER, OK 73932** by (signature) 

INSTRUCTIONS: Use typewriter or ball point pen. PLEASE PRESS FIRMLY and PRINT clearly. Please fill in blanks, underline or circle the correct answers. Send two copies to Kansas Department of Health and Environment, Bureau of Water, Topeka, Kansas 66620-0001. Telephone: 913-296-5545. Send one to WATER WELL OWNER and retain one for your records.

#22978