

1 LOCATION OF WATER WELL:	Fraction	Section Number	Township Number	Range Number
County: Gray	NE $\frac{1}{4}$	NE $\frac{1}{4}$	NE $\frac{1}{4}$	2
Distance and direction from nearest town or city street address of well if located within city?				


2 WATER WELL OWNER: Myrl I FRAZIER

RR#, St. Address, Box # Box 65

City, State, ZIP Code: TANAGALLS KS 67853

Board of Agriculture, Division of Water Resources
Application Number:

3 LOCATE WELL'S LOCATION WITH AN "X" IN SECTION BOX:

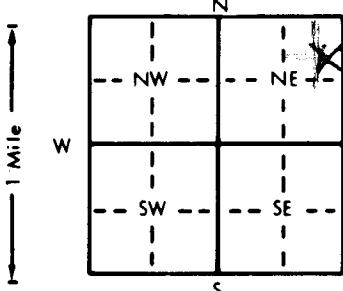

4 DEPTH OF COMPLETED WELL: 999 ft. ELEVATION:

Depth(s) Groundwater Encountered 1 ft. 2 ft. 3 ft. ft.

WELL'S STATIC WATER LEVEL: 999 ft. below land surface measured on mo/day/yr

Pump test data: Well water was ft. after hours pumping gpm

Est. Yield gpm: Well water was ft. after hours pumping gpm

Bore Hole Diameter in. to ft., and in. to ft.

WELL WATER TO BE USED AS: 5 Public water supply 8 Air conditioning 11 Injection well

1 Domestic 3 Feedlot 6 Oil field water supply 9 Dewatering 12 Other (Specify below)

2 Irrigation 4 Industrial 7 Lawn and garden only 10 Monitoring well

Was a chemical/bacteriological sample submitted to Department? Yes.....No..... If yes, mo/day/yr sample was submitted

Water Well Disinfected? Yes No

5 TYPE OF BLANK CASING USED:

1 Steel 3 RMP (SR)
2 PVC 4 ABS

5 Wrought iron

6 Asbestos-Cement
7 Fiberglass

8 Concrete tile

9 Other (specify below)

CASING JOINTS: Glued

Clamped

Welded

Threaded

Blank casing diameter 5 in. to ft. Dia in. to ft. Dia in. to ft.

Casing height above land surface 6.6 Below in. weight lbs./ft. Wall thickness or gauge No. ft.

TYPE OF SCREEN OR PERFORATION MATERIAL:

1 Steel 3 Stainless steel
2 Brass 4 Galvanized steel

5 Fiberglass

6 Concrete tile

7 PVC

8 RMP (SR)

9 ABS

10 Asbestos-cement

11 Other (specify) NA

12 None used (open hole)

SCREEN OR PERFORATION OPENINGS ARE:

1 Continuous slot 3 Mill slot
2 Louvered shutter 4 Key punched

5 Gauzed wrapped

6 Wire wrapped

7 Torch cut

8 Saw cut

9 Drilled holes

10 Other (specify) NA

11 None (open hole)

SCREEN-PERFORATED INTERVALS: From ft. to ft., From ft. to ft. ft. to ft.

From ft. to ft., From ft. to ft. ft. to ft.

GRAVEL PACK INTERVALS: From ft. to ft., From ft. to ft. ft. to ft.

From ft. to ft., From ft. to ft. ft. to ft.

6 GROUT MATERIAL: 1 Neat cement 2 Cement grout 3 Bentonite 4 Other

Grout Intervals: From 5 ft. to 0 ft., From ft. to ft., From ft. to ft., From ft. to ft.

What is the nearest source of possible contamination:

1 Septic tank 4 Lateral lines
2 Sewer lines 5 Cess pool
3 Watertight sewer lines 6 Seepage pit

10 Livestock pens

14 Abandoned water well

11 Fuel storage

15 Oil well/Gas well

12 Fertilizer storage

16 Other (specify below) None

13 Insecticide storage

How many feet?

Direction from well?

FROM TO LITHOLOGIC LOG FROM TO PLUGGING INTERVALS

A BANed pastur 999 5 Gravel
weL Dry HOLE 0 Cement
PLUGged with
No.1 COARSE
GRAvEL
LAST 5' with
Cement

7 CONTRACTOR'S OR LANDOWNER'S CERTIFICATION: This water well was (1) constructed, (2) reconstructed, or (3) plugged under my jurisdiction and was completed on (mo/day/year) 6-1-91 and this record is true to the best of my knowledge and belief. KansasWater Well Contractor's License No. This Water Well Record was completed on (mo/day/year) 6-1-91
under the business name of by (signature) Dan Denton