

WATER WELL RECORD

Form WWC-5

KSA 82a-1212

1 LOCATION OF WATER WELL:		Fraction 1/4	Near the Center 1/4	SE 1/4	Section Number 22	Township Number T 26 S	Range Number R 30 E
---------------------------	--	-----------------	------------------------	-----------	----------------------	---------------------------	------------------------

County: Gray

Distance and direction from nearest town or city street address of well if located within city?

Approximately 2½ miles South, ¼ East, 2 miles West & ½ North of Charleston.

2 WATER WELL OWNER: Vernon Schmidt


RR#, St. Address, Box #: P. O. Box 98

Board of Agriculture, Division of Water Resources

City, State, ZIP Code: Ingalls, Ks. 67853

Application Number: 21,076

3 LOCATE WELL'S LOCATION WITH AN "X" IN SECTION BOX:

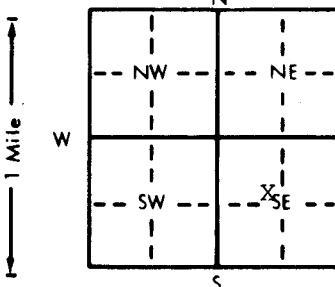

4 DEPTH OF COMPLETED WELL... 273' ft. ELEVATION:

Depth(s) Groundwater Encountered 1. 120' ft. 2. ft. 3. ft.

WELL'S STATIC WATER LEVEL ... 120' ft. below land surface measured on mo/day/yr 3/15/89

Pump test data: Well water was ft. after hours pumping gpm

Est. Yield ... 1300. gpm: Well water was ... 140' ft. after ... 4 hours pumping ... 1304 gpm

Bore Hole Diameter ... 24 in. to ... 273' ft., and ... in. to ... ft.

WELL WATER TO BE USED AS: 5 Public water supply 8 Air conditioning 11 Injection well

1 Domestic 3 Feedlot 6 Oil field water supply 9 Dewatering 12 Other (Specify below)

2 Irrigation 4 Industrial 7 Lawn and garden only 10 Monitoring well

Was a chemical/bacteriological sample submitted to Department? Yes No X If yes, mo/day/yr sample was submitted

Water Well Disinfected? Yes X No

5 TYPE OF BLANK CASING USED:

1 Steel 3 RMP (SR) 5 Wrought iron 8 Concrete tile Casing joints: Glued Clamped

2 PVC 4 ABS 6 Asbestos-Cement 9 Other (specify below) Welded X

Blank casing diameter ... 16 in. to ... 273' ft., Dia in. to ft., Dia in. to ft.

Casing height above land surface ... 12 in., weight ... 42.05 lbs./ft. Wall thickness or gauge No. 250W

TYPE OF SCREEN OR PERFORATION MATERIAL:

1 Steel 3 Stainless steel 5 Fiberglass 7 PVC 10 Asbestos-cement

2 Brass 4 Galvanized steel 6 Concrete tile 9 ABS 11 Other (specify)

12 None used (open hole)

SCREEN OR PERFORATION OPENINGS ARE:

1 Continuous slot 3 Mill slot 5 Gauzed wrapped 8 Saw cut 11 None (open hole)

2 Louvered shutter 4 Key punched 6 Wire wrapped 9 Drilled holes

10 Other (specify)

SCREEN-PERFORATED INTERVALS: From ... 173 ft. to ... 273 ft., From ft. to ft.

From ft. to ft., From ft. to ft.

GRAVEL PACK INTERVALS: From ... 20 ft. to ... 237 ft., From ft. to ft.

From ft. to ft., From ft. to ft.

6 GROUT MATERIAL: 1 Neat cement 2 Cement grout 3 Bentonite 4 Other

Grout Intervals: From ... 0 ft. to ... 20 ft., From ft. to ft., From ft. to ft.

What is the nearest source of possible contamination:

1 Septic tank 4 Lateral lines 7 Pit privy 10 Livestock pens 14 Abandoned water well

2 Sewer lines 5 Cess pool 8 Sewage lagoon 11 Fuel storage 15 Oil well/Gas well

3 Watertight sewer lines 6 Seepage pit 9 Feedyard 12 Fertilizer storage 16 Other (specify below)

13 Insecticide storage

Direction from well? Southeast How many feet? 50'

FROM TO LITHOLOGIC LOG FROM TO PLUGGING INTERVALS

See log attached.

7 CONTRACTOR'S OR LANDOWNER'S CERTIFICATION: This water well was (1) constructed, (2) reconstructed, or (3) plugged under my jurisdiction and was completed on (mo/day/year) ... 3/10/89 and this record is true to the best of my knowledge and belief. Kansas

Water Well Contractor's License No. ... 145 ... This Water Well Record was completed on (mo/day/yr) ... 3/21/89 ... under the business name of Henkle Drilling & Supply company, Inc. by (signature) *Bruce Schmidt*

INSTRUCTIONS: Use typewriter or ball point pen. PLEASE PRESS FIRMLY and PRINT clearly. Please fill in blanks, underline or circle the correct answers. Send top three copies to Kansas Department of Health and Environment, Bureau of Water Protection, Topeka, Kansas 66620-7320. Telephone: 913-296-5514. Send one to WATER WELL OWNER and retain one for your records.

DRILLERS TEST LOG

CUSTOMER'S NAME: Vernon Schmidt
STREET ADDRESS: P. O. Box 98
CITY & STATE: Ingalls, Ks. 67853
COUNTY Gray **QUARTER** SE **SECTION** 22

DATE: 1/24/89
TEST # 1 E. LOG Yes
DRILLER Shelden
WNSHIP 26 RANGE 30

LOCATION 50' Northwest of the old well.

GARDEN CITY, KS 67846
3795 West Jones Ave.

HENKLE DRILLING & SUPPLY CO., INC.

316-277-2389

IRRIGATION HEADQUARTERS