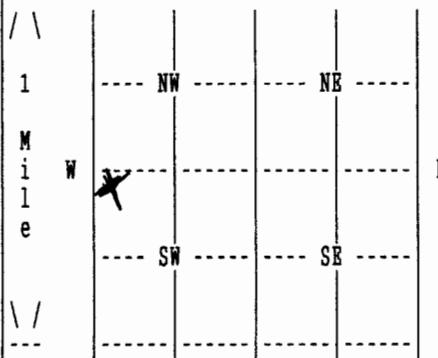


WATER WELL RECORD Form WWC-5 KSA 82a-1212

1 LOCATION OF WATER WELL: COUNTY: 035 GRAY	Fraction NW 1/4 NW 1/4 SW 1/4	Section Number 24	Township Number T 26 S	Range Number R 30 W
---	----------------------------------	----------------------	---------------------------	------------------------

Distance and direction from nearest town or city street address of well if located within city?
FROM CHARLESTON; APPX 6 1/2 MILES SOUTH

2 WATER WELL OWNER: RR#, St. Address, Box # : City, State, ZIP code :	TONY BLEUMER 16504 7 ROAD INGALLS, KS 67853-	Board of Agriculture, Division of Water Resources Application Number: 24241
3 LOCATE WELL'S LOCATION WITH AN "X" IN SECTION BOX:	4 DEPTH OF COMPLETED WELL 315 ELEVATION: 0 Depth(s) Groundwater Encountered 1. 0 ft. 2. 0 ft. 3. 0 ft. WELL'S STATIC WATER LEVEL 148 ft. below land surface measured on mo/day/yr 04/14/05 Pump test data: Well water was 220 ft. after 4 hours pumping 150 gpm Estimated Yield 0 gpm: Well water was 0 ft. after 0 hours pumping 0 gpm Bore Hole Diameter 24 in. to 315 ft., and in. to 0 ft. WELL WATER TO BE USED AS: 02 IRRIGATION Was a chemical/bacteriological sample submitted to department? No ; If yes, mo/day/yr sample was submitted Water well disinfected? Yes	
 1 ----- NW ----- NE M i l e W X ----- E ----- SW ----- SE		

5 TYPE OF BLANK CASING USED: 01 STEEL	CASING JOINTS: WELDED
Blank casing diameter 16 in. to 315 ft., Dia in. to 0 ft., Dia in. to 0 ft.	
Casing height above land surface 12 in., weight 42 lbs/ft. Wall thickness or gauge No. .250	
TYPE OF SCREEN OR PERFORATION MATERIAL: 01 STEEL	
SCREEN OR PERFORATION OPENINGS ARE: 01 CONT. SLOT	
SCREEN PERFORATED INTERVALS:	From 160 ft. to 190 ft., From 290 ft. to 300 ft. From 223 ft. to 273 ft., From 0 ft. to 0 ft.
GRAVEL PACK INTERVALS:	From 20 ft. to 315 ft., From 0 ft. to 0 ft. From 0 ft. to 0 ft., From 0 ft. to 0 ft.

6 GROUT MATERIAL 03 BENTONITE	
Grout Intervals: From 0 ft. to 20 ft., From 0 ft. to 0 ft., From 0 ft. to 0 ft.	
What is the nearest source of possible contamination: NONE OBSERVED	
Direction from well?	How many feet? 0

FROM	TO	LITHOLOGIC LOG	FROM	TO	PLUGGING INTERVALS
0	2	02 SILT			
2	10	01 CLAY 31 CALICHE 05 SAND			
10	33	07 FINE SAND 01 CLAY			
33	60	01 CLAY 07 FINE SAND			
60	107	05 SAND 11 GRAVEL 01 CLAY			
107	136	05 SAND 11 GRAVEL			
136	143	01 CLAY 20 LIMESTONE			
143	148	05 SAND			
148	157	07 FINE SAND 08 MEDIUM SAND 01 CLAY			
157	172	05 SAND			

7 CONTRACTOR'S OR LANDOWNER'S CERTIFICATION: This water well was Constructed under my jurisdiction and was completed on (mo/day/year) 04/08/05 and this record is true to the best of my knowledge and belief. Kansas Water Well Contractor's License No. 145 This Water Well Record was completed on (mo/day/yr) 07/22/05 under the business name of HENKLE DRILLING & SUPPLY	by (signature)
--	----------------

(Continued)

WATER WELL RECORD Form WWC-5 KSA 82a-1212

1 LOCATION OF WATER WELL: COUNTY: 035 GRAY	Fraction NW 1/4 NW 1/4 SW 1/4	Section Number 24	Township Number T 26 S	Range Number R 30 W
---	----------------------------------	----------------------	---------------------------	------------------------

2 WATER WELL OWNER:
TONY BLEUMER
RR#, St. Address, Box # : 16504 7 ROAD
City, State, ZIP code : INGALLS, KS 67853-

Board of Agriculture, Division of Water Resources
Application Number: 24241

FROM	TO	LITHOLOGIC LOG
172	184	05 SAND 01 CLAY
184	223	01 CLAY
223	273	07 FINE SAND 01 CLAY
273	281	01 CLAY
281	287	01 CLAY
287	300	05 SAND 28 ROCK 23 SANDSTONE
300	303	31 CALICHE
303	320	19 SHALE

7 CONTRACTOR'S OR LANDOWNER'S CERTIFICATION: This water well was Constructed under my jurisdiction and was completed on (mo/day/year) 04/08/05 and this record is true to the best of my knowledge and belief. Kansas Water Well Contractor's License No. 145 This Water Well Record was completed on (mo/day/yr) 07/22/05 under the business name of HENKLE DRILLING & SUPPLY by (signature) *Bernie Reichert*