WATER WELL RECORD Form WWC-5 KSA 82a-1212 ID No. _____

1 LOCATION OF WATER WELL:	Fraction	Section Number	Township Number	Range Number
County: Gray	NE ¼ SW ¼ NE ¼	9	T 26 S	R 30 E/W

Distance and direction from nearest town or city street address of well if located within city?
2 3/4 miles South 1/4 mile west, 1 1/4 south, 11/4 west 1/4 south of Charleston

2 WATER WELL OWNER: Eugene & R. John Nally
RR#, St. Address, Box # : 19605 1 Road
City, State, ZIP Code : Pierceville, Kansas 67868
Board of Agriculture, Division of Water Resources
Application Number: 21750

3 LOCATE WELL'S LOCATION WITH AN "X" IN SECTION BOX:

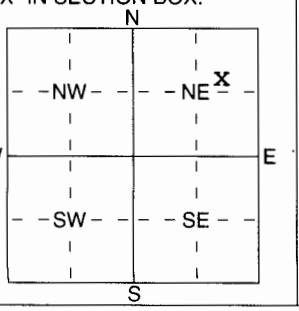

4 DEPTH OF COMPLETED WELL 320 ft. ELEVATION:
Depth(s) Groundwater Encountered 1 190 ft. 2 252 ft. 3 289 304 ft.
WELL'S STATIC WATER LEVEL 172' ft. below land surface measured on mo/day/yr 12-26-07
Pump test data: Well water was ft. after hours pumping gpm
Est. Yield 1200 gpm: Well water was ft. after hours pumping gpm
WELL WATER TO BE USED AS: 1 Domestic 2 Irrigation 3 Feedlot 4 Industrial 5 Public water supply 6 Oil field water supply 7 Domestic (lawn & garden) 8 Air conditioning 9 Dewatering 10 Monitoring well 11 Injection well 12 Other (Specify below)
Was a chemical/bacteriological sample submitted to Department? Yes ..... No X; If yes, mo/day/yrs sample was submitted
Water Well Disinfected? Yes X No

5 TYPE OF BLANK CASING USED: 1 Steel 2 PVC 3 RMP (SR) 4 ABS 5 Wrought iron 6 Asbestos-Cement 7 Fiberglass 8 Concrete tile 9 Other (specify below)
CASING JOINTS: Glued X & bolted Clamped Welded Threaded
Blank casing diameter 16 in. to 0-260 ft., Dia in. to ft., Dia in. to ft.
Casing height above land surface 12 in., weight lbs./ft. Wall thickness or guage No. SDR26

TYPE OF SCREEN OR PERFORATION MATERIAL: 1 Steel 2 Brass 3 Stainless Steel 4 Galvanized Steel 5 Fiberglass 6 Concrete tile 7 PVC 8 RMP (SR) 9 ABS 10 Asbestos-Cement 11 Other (Specify) 12 None used (open hole)

SCREEN OR PERFORATION OPENINGS ARE: 1 Continuous slot 2 Louvered shutter 3 Mill slot 4 Key punched 5 Guazed wrapped 6 Wire wrapped 7 Torch cut 8 Saw cut 9 Drilled holes 10 Other (specify) 11 None (open hole)

SCREEN-PERFORATED INTERVALS: From 260-300 PVC ft. to 300-320 wirewrap ft., From ft. to ft.
From ft. to ft., From ft. to ft.
GRAVEL PACK INTERVALS: From 20-320 ft. to ft., From ft. to ft.
From ft. to ft., From ft. to ft.

6 GROUT MATERIAL: 1 Neat cement 2 Cement grout 3 Bentonite 4 Other
Grout Intervals: From 0-16 Cement ft. to 16-20 Bentonite ft., From ft. to ft., From ft. to ft.

What is the nearest source of possible contamination:
1 Septic tank 2 Sewer lines 3 Watertight sewer lines 4 Lateral lines 5 Cess pool 6 Seepage pit 7 Pit privy 8 Sewage lagoon 9 Feedyard 10 Livestock pens 11 Fuel storage 12 Fertilizer storage 13 Insecticide storage 14 Abandoned water well 15 Oil well/Gas well 16 Other (specify below)
Direction from well? How many feet?

FROM	TO	LITHOLOGIC LOG	FROM	TO	PLUGGING INTERVALS
0	5	Top Soil & fine Sand	225	240	Clay & little lime (hard)
5	15	Clay	240	252	Clay & little lime
15	30	Clay & fine sand	252	270	Sand & 1' Clay
30	47	Sand	270	275	Sand
47	60	Clay, lime & fine sand	275	285	Clay & little lime
60	85	Clay, lime & fine sand	285	289	Clay & little lime
85	90	Sand & little clay	289	300	Sand
90	105	Sand & little clay	300	302	Lime
105	120	Sand & gravel	302	304	Lime (hard)
120	190	Sand & gravel	304	312	Sand (coarse) & cemented sand
190	195	Gravel & cemented sand	312	315	Clay
195	201	Gravel & cemented sand (hard)	315	320	Clay & little lime (hard)
201	210	Sand	320	330	Shale (hard) with rock
210	225	Sand & little clay			

7 CONTRACTOR'S OR LANDOWNER'S CERTIFICATION: This water well was (1) constructed, (2) reconstructed, or (3) plugged under my jurisdiction and was completed on (mo/day/year) 12-26-07 and this record is true to the best of my knowledge and belief. Kansas Water Well Contractor's Licence No 223 This Water Well Record was completed on (mo/day/yr) 1-24-08
under the business name of Dunham Drilling Inc. by (signature) Karen Dunham

INSTRUCTIONS: Use typewriter or ball point pen. *PLEASE PRESS FIRMLY* and *PRINT* clearly. Please fill in blanks, underline or circle the correct answers. Send top three copies to Kansas Department of Health and Environment, Bureau of Water, Geology Section, 1000 SW Jackson St., Suite 420, Topeka, Kansas 66612-1367. Telephone 785-296-5522. Send one to WATER WELL OWNER and retain one for your records. Fee of $5.00 for each constructed well.