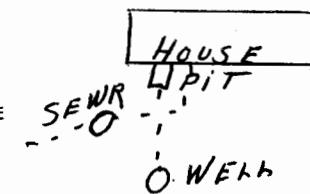


USE TYPEWRITER OR BALL
POINT PEN-PRESS FIRMLY,
PRINT CLEARLY.

WATER WELL RECORD
KSA 82a-1201-1215

Kansas Department of Health and
Environment-Division of Environment
(Water well Contractors)
Topeka, Kansas 66620

1. Location of well:	County	Fraction	Section number	Township number	Range number
	Gray	NE 1/4 NE 1/4 NW 1/4	#2	T #26	S R #30 E W
2. Distance and direction from nearest town or city:	2 1/2 miles south of Charleston, Ks. on country road.		3. Owner of well:	Myrl Frazier	
Street address of well location if in city:			R.R. or street:		
4. Locate with "X" in section below:	Sketch map:		6. Bore hole dia.	in. Completion date	
			Well depth	205 ft. 8-30-76	
5. Type and color of material	From	To	7. <input checked="" type="checkbox"/> Cable tool <input type="checkbox"/> Rotary <input type="checkbox"/> Driven <input type="checkbox"/> Dug <input type="checkbox"/> Hollow rod <input type="checkbox"/> Jetted <input type="checkbox"/> Bored <input type="checkbox"/> Reverse rotary		
Sandy topsoil	0	15	8. Use: <input checked="" type="checkbox"/> Domestic <input type="checkbox"/> Public supply <input type="checkbox"/> Industry <input type="checkbox"/> Irrigation <input type="checkbox"/> Air conditioning <input type="checkbox"/> Stock <input type="checkbox"/> Lawn <input type="checkbox"/> Oil field water <input type="checkbox"/> Other		
Medium to coarse sand	15	60	9. Casing: Material <input checked="" type="checkbox"/> RMP <input type="checkbox"/> Threaded <input type="checkbox"/> Welded <input type="checkbox"/> Surface 12 in. RMP <input checked="" type="checkbox"/> PVC <input type="checkbox"/> Weight lbs./ft. Dia. 5 in. to 205 ft. depth Wall thickness inches or Dia. in. to ft. depth gage No. 250		
Medium to coarse sand & clay	60	105	10. Screen: Manufacturer's name <input checked="" type="checkbox"/> Sunflower Type <input checked="" type="checkbox"/> RMP Dia. 5" Slot/size 1/8" Length 20 ft. Set between 180 ft. and 200 ft. Gravel pack? <input checked="" type="checkbox"/> yes Size range of material 1"		
Coarse sand & clay	105	120	11. Static water level: mo./day/yr. 73 ft. below land surface Date 8-30-76		
Clay	120	135	12. Pumping level below land surfaces: 80 ft. after 1 hrs. pumping 50 g.p.m. ft. after hrs. pumping g.p.m. Estimated maximum yield 70 g.p.m.		
Medium sand & clay layers	135	150	13. Water sample submitted: mo./day/yr. Yes <input checked="" type="checkbox"/> No Date		
Clay	150	165	14. Well head completion: <input checked="" type="checkbox"/> Pitless adapter 12 inches above grade		
Medium to coarse sand	165	195	15. Well grouted? <input checked="" type="checkbox"/> yes With: <input checked="" type="checkbox"/> Neat cement <input type="checkbox"/> Bentonite <input type="checkbox"/> Concrete Depth: From 7 ft. to 15 ft.		
Medium to coarse sand & clay	195	210	16. Nearest source of possible contamination: ft. 100 Direction North Type Sewer Well disinfected upon completion? <input checked="" type="checkbox"/> Yes <input type="checkbox"/> No		
Shale	210		17. Pump: Not installed Manufacturer's name <input checked="" type="checkbox"/> Aeromotor Model number SD10-50 HP 1/2 Volts 230 Length of drop pipe 105 ft. capacity 12 g.p.m. Type: <input checked="" type="checkbox"/> Submersible <input type="checkbox"/> Turbine <input type="checkbox"/> Jet <input type="checkbox"/> Reciprocating <input type="checkbox"/> Centrifugal <input type="checkbox"/> Other		
(Use a second sheet if needed)			20. Water well contractor's certification: This well was drilled under my jurisdiction and this report is true to the best of my knowledge and belief. Joe's Well Service 179 Business name <input type="checkbox"/> License No. Address <input type="checkbox"/> Box 174 Cimarron, Ks. Signed <input type="checkbox"/> Larry Crick 10-5-76 Date <input type="checkbox"/> Authorized representative		
18. Elevation:	19. Remarks:				
Topography: <input type="checkbox"/> Hill <input type="checkbox"/> Slope <input checked="" type="checkbox"/> Upland <input type="checkbox"/> Valley					