USE TYPEWRITER OR BALL POINT PEN-PRESS FIRMLY, PRINT CLEARLY.

Gray County

WATER WELL RECORD
KSA 82a-1201-1215

Kansas Department of Health and Environment-Division of Environment
(Water well Contractors)
Topeka, Kansas 66620

1. Location of well:	County ~~Finney~~ Gray Co.	Fraction	Section number	Township number	Range number
		SE 1/4 NW 1/4 SE 1/4	5	T 26 S	R 30 E (W)

2. Distance and direction from nearest town or city: 4 south, 3¼ west, ¼ north of Charleston.
Street address of well location if in city:

3. Owner of well: Don Renick (#66)
R.R. or street:
City, state, zip code: Ingalls, Ks. 67853

4. Locate with "X" in section below: Sketch map:

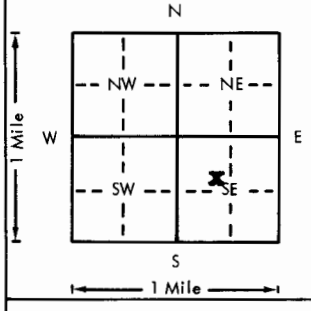

6. Bore hole dia. 26 in. Completion date 6-28-77
Well depth 302 ft.

7. ___ Cable tool ___ Rotary ___ Driven ___ Dug
___ Hollow rod ___ Jetted ___ Bored X Reverse rotary

8. Use: ___ Domestic ___ Public supply ___ Industry
X Irrigation ___ Air conditioning ___ Stock
___ Lawn ___ Oil field water ___ Other

9. Casing: Material steel Height: Above ~~ground~~
Threaded ___ Welded X Surface 12 in.
RMP ___ PVC ___ Weight 36.87 lbs./ft.
Dia. 16 in. to 303 ft. depth Wall Thickness: inches or
Dia. ___ in. to ___ ft. depth gage No. .250 .219 MNC

5. Type and color of material	From	To
(Use a second sheet if needed)		

10. Screen: Manufacturer's name Johnson
Type galv. Dia. 16"
Slot/~~Saw~~ Length ~~10 ft.~~ 20'
Set between 210-220 ft. and 280-290 ft.
Perf: 110-210 ft. and 220-280, 290-302
Gravel pack? yes Size range of material ½" down

11. Static water level: mo./day/yr.
117 ft. below land surface Date 5-10-77

12. Pumping level below land surfaces:
121 ft. after 2 hrs. pumping 900 g.p.m.
126 ft. after 4 hrs. pumping 1500 g.p.m.
Estimated maximum yield 1500 g.p.m.

13. Water sample submitted: mo./day/yr.
___ Yes X No Date

14. Well head completion:
___ Pitless adapter 12 Inches above grade

15. Well grouted? Yes
With: ___ Neat cement ___ Bentonite X Concrete
Depth: From 0 ft. to 10 ft.

16. Nearest source of possible contamination: N/A
ft. ___ Direction ___ Type ___
Well disinfected upon completion? ___ Yes X No

17. Pump: ___ Not installed
Manufacturer's name Goulds-US Pump
Model number 12JLMO HP 60 Volts
Length of drop pipe 160 ft. capacity 1500 g.p.m.
Type:
___ Submersible X Turbine
___ Jet ___ Reciprocating
___ Centrifugal ___ Other

18. Elevation:

Topography:
___ Hill
X Slope
___ Upland
___ Valley

19. Remarks:

20. Water well contractor's certification:
This well was drilled under my jurisdiction and this report is true to the best of my knowledge and belief.
Minter-Wilson Drilling Co. 208
Business name License No.
Address Box A Garden City, Ks.
Signed Irene Lee Reyes Authorized representative Date 11-28-77

T 26 R 30 E Sec 05 SE 1/4 NW 1/4 SE 1/4

Forward the white, blue and pink copies to the Department of Health and Environment

Form WWC-5

MI-1023