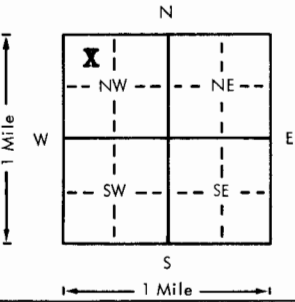


USE TYPEWRITER OR BALL
POINT PEN-PRESS FIRMLY,
PRINT CLEARLY.

WATER WELL RECORD
KSA 82a-1201-1215

Kansas Department of Health and
Environment-Division of Environment
(Water well Contractors)
Topeka, Kansas 66620

1. Location of well:		County Gray County	Fraction 1/4 1/4 NW 1/4	Section number 6	Township number T 26 S R 30	Range number 30
2. Distance and direction from nearest town or city: 4 1/2 West, 1/2 South		of well: Anna Johnson (Owner) Bob Husband (Tenant)		R.R. or street: Pierceville, KS 67868		
3. Street address of well location if in city:		City, state, zip code:				
4. Locate with "X" in section below:		Sketch map:		6. Bore hole dia. 26 in. Completion date 3-21-79 Well depth 260 ft.		
				7. Cable tool <input type="checkbox"/> Rotary <input type="checkbox"/> Driven <input type="checkbox"/> Dug <input type="checkbox"/> Hollow rod <input type="checkbox"/> Jetted <input type="checkbox"/> Bored <input checked="" type="checkbox"/> Reverse rotary		
5. Type and color of material		From	To	8. Use: Domestic <input type="checkbox"/> Public supply <input type="checkbox"/> Industry <input checked="" type="checkbox"/> Irrigation <input type="checkbox"/> Air conditioning <input type="checkbox"/> Stock <input type="checkbox"/> Lawn <input type="checkbox"/> Oil field water <input type="checkbox"/> Other		
				9. Casing: Material Steel Height: Above or below Threaded <input type="checkbox"/> Welded <input checked="" type="checkbox"/> Surface 1 ft. in. RMP <input type="checkbox"/> PVC <input type="checkbox"/> Weight 36.87 lbs./ft. Dia 16 in. to 260 ft. depth Wall Thickness: inches or Dia. <input type="checkbox"/> in. to <input type="checkbox"/> ft. depth Gage No. .219		
				10. Screen: Manufacturer's name Johnson Type Johnson Galv. Di 100-16" Slot/gauze 0-100 Plain 100-200 Perf. Set between 200-235 Plain 235-255 Screen 255-260 Perf. Gravel pack? yes Size range of material 1/2 to 5/8		
				11. Static water level: 80 ft. below land surface Date <input type="checkbox"/>		
				12. Pumping level below land surfaces: 73 ft. after 2 hrs. pumping 600 g.p.m. 79 ft. after 4 hrs. pumping 1200 g.p.m. Estimated maximum yield 1200 g.p.m.		
				13. Water sample submitted: <input type="checkbox"/> Yes <input checked="" type="checkbox"/> No Date <input type="checkbox"/>		
				14. Well head completion: <input type="checkbox"/> Pitless adapter 1 ft. inches above grade		
				15. Well grouted? yes With: <input type="checkbox"/> Neat cement <input type="checkbox"/> Bentonite <input checked="" type="checkbox"/> Concrete Depth: From 0 ft. to 10 ft.		
				16. Nearest source of possible contamination: ft. <input type="checkbox"/> Direction N/A Type <input type="checkbox"/> Well disinfected upon completion? <input type="checkbox"/> Yes <input type="checkbox"/> No		
				17. Pump: <input type="checkbox"/> Not installed Manufacturer's name Could 5 stg. 12" Bowl Model number <input type="checkbox"/> HP 100 Volts <input type="checkbox"/> Length of drop pipe 160 ft. capacity 1000 g.p.m. Type: <input type="checkbox"/> Submersible <input checked="" type="checkbox"/> Turbine <input type="checkbox"/> Jet <input type="checkbox"/> Reciprocating <input type="checkbox"/> Centrifugal <input type="checkbox"/> Other		
18. Elevation:		19. Remarks:		20. Water well contractor's certification: This well was drilled under my jurisdiction and this report is true to the best of my knowledge and belief. Minter Wilson Drilling Co. 208 Business name Box A, Garden City, KS 67846 License No. 67846 Signature [Signature] Date 3/27/79 Authorized representative		
Topography: <input checked="" type="checkbox"/> Hill <input type="checkbox"/> Slope <input type="checkbox"/> Upland <input type="checkbox"/> Valley						

Forward the white, blue and pink copies to the Department of Health and Environment

Form WWC-5

WILSON DRILLING CO.
INCORPORATED

Irrigation
and Domestic
Water Systems
Complete Installation
and Repairing

Phone 276-8269 • P.O. Box A • GARDEN CITY, KANSAS 67846

December 1, 1978

Anna Johnson - Owner
Bob Husband - Tenant
Gray County

Location: N. W. $\frac{1}{4}$ 6-26-30 Pierceville and Plymell Jct. 2
mile East, $\frac{1}{4}$ mile North, 1320' East 1320 North,
35 North West of Pivot

Static Water Level - 80

Test #

0	10	Top Soil (fine)
10	53	Fine Sand Clay mixed
53	65	Fine to med. sand and gravel
65	112	Coarse Gravel (loose)
112	145	Fine to med. sand and gravel streak of coarse Gravel (loose)
145	149	Brown Clay small streak of coarse gravel
149	156	Brown Clay
156	168	Fine to med. sand and gravel streak of coarse Gravel (loose)
168	194	Fine to med. sand and gravel Clay streak mixed (loose)
194	200	Fine to med. sand and fine gravel clay mixed (tight)
200	215	Fine sand Clay streak mixed (loose)
215	219	Fine to med. Sand (loose)
219	238	Brown Sandy Clay
238	255	Fine to med. sand and fine gravel mixed small 20% White Rock Tight
255	267	Yellow Clay hard pull down
267	272	Shale hard pull down