

1 LOCATION OF WATER WELL:

Fraction

NE 1/4 NE 1/4 NE 1/4

Section Number

9

Township Number

T

26 S

Range Number

R 30 EW

County: Gray
Distance and direction from nearest town or city street address of well if located within city?

From Charleston, 4 miles south on Charleston Rd., then 3 miles west.

2 WATER WELL OWNER: Kent Schmidt


RR#, St. Address, Box #: 14003 4 Rd.

Board of Agriculture, Division of Water Resources

City, State, ZIP Code: Ingalis, KS. 67853

Application Number:

3 LOCATE WELL'S LOCATION WITH AN "X" IN SECTION BOX:

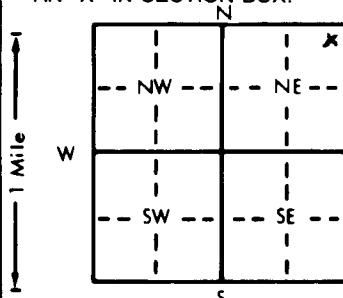

4 DEPTH OF COMPLETED WELL ft. ELEVATION:

Depth(s) Groundwater Encountered 1. ft. 2. ft. 3. ft.

WELL'S STATIC WATER LEVEL ft. below land surface measured on mo/day/yr 8-32-97

Pump test data: Well water was ft. after hours pumping gpm

Est. Yield gpm: Well water was ft. after hours pumping gpm

Bore Hole Diameter in. to ft. and in. to ft.

WELL WATER TO BE USED AS: 5 Public water supply 8 Air conditioning 11 Injection well

Domestic 3 Feedlot 6 Oil field water supply 9 Dewatering 12 Other (Specify below)

2 Irrigation 4 Industrial 7 Lawn and garden only 10 Monitoring well

Was a chemical/bacteriological sample submitted to Department? Yes No If yes, mo/day/yr sample was submitted

Water Well Disinfected? Yes X No

5 TYPE OF BLANK CASING USED:

1 Steel 3 RMP (SR)

PVC 4 ABS

5 Wrought iron

6 Asbestos-Cement

7 Fiberglass

8 Concrete tile

9 Other (specify below)

CASING JOINTS: Glued X Clamped

Welded

Threaded

Blank casing diameter 5" in. to 250 ft., Dia in. to ft., Dia in. to ft.

Casing height above land surface 12 in., weight lbs./ft. Wall thickness or gauge No. 50R 21

TYPE OF SCREEN OR PERFORATION MATERIAL:

1 Steel 3 Stainless steel

2 Brass 4 Galvanized steel

5 Fiberglass

6 Concrete tile

5 Gauzed wrapped

8 RMP (SR)

9 ABS

10 Asbestos-cement

7 PVC

11 Other (specify)

12 None used (open hole)

11 None (open hole)

SCREEN OR PERFORATION OPENINGS ARE:

1 Continuous slot 3 Mill slot

2 Louvered shutter 4 Key punched

6 Wire wrapped

7 Torch cut

8 Saw cut

9 Drilled holes

10 Other (specify)

SCREEN-PERFORATED INTERVALS: From 250 ft. to 290 ft., From ft. to ft.

From ft. to ft., From ft. to ft.

GRAVEL PACK INTERVALS: From 24 ft. to 290 ft., From ft. to ft.

From ft. to ft., From ft. to ft.

6 GROUT MATERIAL: 1 Neat cement 2 Cement grout 3 Bentonite 4 Other

Grout Intervals: From 4 ft. to 35 ft., From ft. to ft., From ft. to ft.

What is the nearest source of possible contamination: 10 Livestock pens 14 Abandoned water well

1 Septic tank 4 Lateral lines 7 Pit privy 11 Fuel storage 15 Oil well/Gas well

2 Sewer lines 5 Cess pool 8 Sewage lagoon 12 Fertilizer storage 16 Other (specify below)

3 Watertight sewer lines 6 Seepage pit 9 Feedyard 13 Insecticide storage

Direction from well? North How many feet? 215

FROM TO LITHOLOGIC LOG FROM TO PLUGGING INTERVALS

| | | | | | |
|-----|-----|-------------------------------------|------|----|--------------------|
| 0 | 1 | Topsoil | FROM | TO | PLUGGING INTERVALS |
| 1 | 45 | Fine sand | | | |
| 45 | 63 | Brown clay | | | |
| 63 | 78 | Brown sandy clay | | | |
| 78 | 100 | Med. sand | | | |
| 100 | 105 | Fine sand | | | |
| 105 | 184 | Med. sand | | | |
| 184 | 200 | Course sand | | | |
| 200 | 230 | Brown sandy clay | | | |
| 230 | 260 | Med. sand | | | |
| 260 | 370 | Brown sandy clay | | | |
| 370 | 280 | Med. sand & brown sandy clay layers | | | |
| 280 | 290 | Med. sand | | | |

7 CONTRACTOR'S OR LANDOWNER'S CERTIFICATION: This water well was (1) constructed, (2) reconstructed, or (3) plugged under my jurisdiction and was completed on (mo/day/year) 8-32-97 and this record is true to the best of my knowledge and belief. Kansas

Water Well Contractor's License No. 533 This Water Well Record was completed on (mo/day/yr) 8-24-97

under the business name of Jantzen Water Well Repair by (signature) 

INSTRUCTIONS: Use typewriter or ball point pen. PLEASE PRESS FIRMLY and PRINT clearly. Please fill in blanks, underline or circle the correct answers. Send top three copies to Kansas Department of Health and Environment, Bureau of Water, Topeka, Kansas 66620-0001. Telephone: 913-296-5545. Send one to WATER WELL OWNER and retain one for your records.