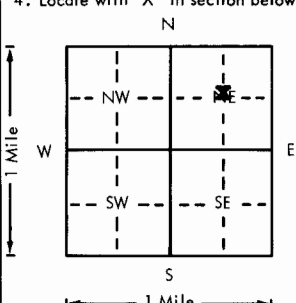


USE TYPEWRITER OR BALL
POINT PEN-PRESS FIRMLY,
PRINT CLEARLY.

WATER WELL RECORD
KSA 82a-1201-1215

Kansas Department of Health and
Environment-Division of Environment
(Water well Contractors)
Topeka, Kansas 66620

1. Location of well:	County Gray County	Fraction 1/4 1/4 NE 1/4	Section number 30	Township number T 26 S	Range number R 30 E W
2. Distance and direction from nearest town or city: 3 South of Microwave Tower on Pierceville Plymell Road, 3/4 East			Owner of well: Hugh Andrews R.R. or street: Pierceville, KS 67868 City, state, zip code:		
4. Locate with "X" in section below: 			Sketch map:		
5. Type and color of material			From	To	6. Bore hole dia. 26 in. Completion date 6-78 Well depth 235 ft.
					7. <input type="checkbox"/> Cable tool <input type="checkbox"/> Rotary <input type="checkbox"/> Driven <input type="checkbox"/> Dug <input type="checkbox"/> Hollow rod <input type="checkbox"/> Jetted <input type="checkbox"/> Bored <input checked="" type="checkbox"/> Reverse rotary
					8. Use: <input type="checkbox"/> Domestic <input type="checkbox"/> Public supply <input type="checkbox"/> Industry <input checked="" type="checkbox"/> Irrigation <input type="checkbox"/> Air conditioning <input type="checkbox"/> Stock <input type="checkbox"/> Lawn <input type="checkbox"/> Oil field water <input type="checkbox"/> Other
					9. Casing: Material Steel Height: Above or below Threaded <input type="checkbox"/> Welded <input checked="" type="checkbox"/> Surface 1 ft. in. RMP <input type="checkbox"/> PVC <input type="checkbox"/> Weight 36.87 lbs./ft. Dia. 16 in. to 235 ft. depth Wall Thickness: inches or Dia. 16 in. to 235 ft. depth gage No. .219
					10. Screen: Manufacturer's name Johnson Type Johnson Calv Dia. 100-16" Slot/gauze 0-95 Plain 95-110 Perf. 110-150 Plain 150-160 Perf. 160-200 Plain 200-230 Screen 230-235 Gravel pack? yes Size range of material 1/4 to 5/8 perf.
					11. Static water level: 85 ft. below land surface Date 4-11-78
					12. Pumping level below land surfaces: 113 ft. after 2 hrs. pumping 825 g.p.m. 139 ft. after 4 hrs. pumping 1350 g.p.m. Estimated maximum yield 1350 g.p.m.
					13. Water sample submitted: yes <input checked="" type="checkbox"/> No Date
					14. Well head completion: <input type="checkbox"/> Pitless adapter 1 ft./inches above grade
					15. Well grouted? Yes With: <input type="checkbox"/> Neat cement <input type="checkbox"/> Bentonite <input checked="" type="checkbox"/> Concrete Depth: From 0 ft. to 10 ft.
					16. Nearest source of possible contamination: ft. N/A Direction N/A Type N/A Well disinfected upon completion? <input type="checkbox"/> Yes <input type="checkbox"/> No
					17. Pump: <input type="checkbox"/> Not installed Manufacturer's name Customers Pump Model number 208 HP 300 Volts 30 Length of drop pipe 300 ft. capacity 30 g.p.m. Type: <input type="checkbox"/> Submersible <input type="checkbox"/> Turbine <input type="checkbox"/> Jet <input type="checkbox"/> Reciprocating <input type="checkbox"/> Centrifugal <input type="checkbox"/> Other
18. Elevation:			19. Remarks:		
Topography: <input checked="" type="checkbox"/> Hill <input type="checkbox"/> Slope <input type="checkbox"/> Upland <input type="checkbox"/> Valley			20. Water well contractor's certification: This well was drilled under my jurisdiction and this report is true to the best of my knowledge and belief. Minter Wilson Drilling Co. 208 Business name Box A, Garden City, KS No. 67846 Address Box A, Garden City, KS Signed M. Wilson Date 6-78 Authorized representative		

Forward the white, blue and pink copies to the Department of Health and Environment

Form WWC-5

The Professionals

MINTER-WILSON DRILLING CO.
INCORPORATED

Irrigation
and Domestic
Water Systems
Complete Installation
and Repairing

Phone 276-8269 • P.O. Box A • GARDEN CITY, KANSAS 67846

HUGH ANDREWS
GRAY COUNTY
3-28-78

Location: NE 30-26-30 50 ft. west of well

Static Water Level- 84'

#5

0	1	Top soil
1	43	Brown clay
43	84	Med. to coarse gravel (Loose)
84	92	Brown clay
92	108	Fine to med. sand and gravel (Loose)
108	150	Brown clay
150	159	Fine to med. sand and gravel 10% clay (Fairly Loose)
159	198	Brown clay
198	211	Fine to med. sand and gravel 10% clay (Loose)
211	219	Brown clay
219	231	Fine to med. sand and gravel (Loose)
231	243	Brown and yellow clay with rock (Hard)
243	245	Shale (Hard)
		T.D. 235'
		95 plain
		15 perf
		40 plain
		10 perf
		40 plain
		30 screen
		5 perf