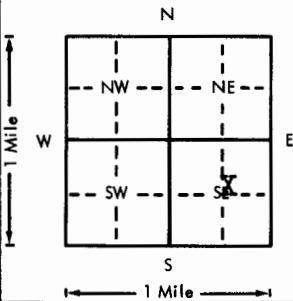


USE TYPEWRITER OR BALL
POINT PEN-PRESS FIRMLY,
PRINT CLEARLY.

WATER WELL RECORD
KSA 82a-1201-1215

Kansas Department of Health and
Environment-Division of Environment
(Water well Contractors)
Topeka, Kansas 66620

1. Location of well:	County GRAY	Fraction SW 1/4 NE SW 1/4 SE 1/4	Section number 35	Township number T 26 S	Range number R 30 E/W
2. Distance and direction from nearest town or city: Street address of well location if in city:	8 3/4 South, 1/4 West of Charleston, KS		3. Owner of well: R.R. or street: City, state, zip code:	Henry Schmidt Montezuma, Kansas 67867	
4. Locate with "X" in section below:	Sketch map: 		6. Bore hole dia. 26 in. Completion date 9-20-75 Well depth 230 ft.		
5. Type and color of material	From	To	7. <input type="checkbox"/> Cable tool <input type="checkbox"/> Rotary <input type="checkbox"/> Driven <input type="checkbox"/> Dug <input type="checkbox"/> Hollow rod <input type="checkbox"/> Jetted <input type="checkbox"/> Bored <input checked="" type="checkbox"/> Reverse rotary		
			8. Use: <input checked="" type="checkbox"/> Domestic <input type="checkbox"/> Public supply <input type="checkbox"/> Industry <input checked="" type="checkbox"/> Irrigation <input type="checkbox"/> Air conditioning <input type="checkbox"/> Stock <input type="checkbox"/> Lawn <input type="checkbox"/> Oil field water <input type="checkbox"/> Other		
			9. Casing: Material Steel Height: Above or below Threaded <input type="checkbox"/> Welded <input type="checkbox"/> Surface 12 in. RMP <input type="checkbox"/> PVC <input type="checkbox"/> Weight 36.87 lbs./ft. Dia. 16 in. to 231 ft. depth Wall Thickness: inches or Dia. <input type="checkbox"/> in. to <input type="checkbox"/> ft. depth gage No. <input type="checkbox"/>		
			10. Screen: Manufacturer's name Johnson Division Type Galvanized Dia. 16"! Slot/gauze <input type="checkbox"/> Length 20' Set between 190 ft. and 210 ft. Perf: 80-190 ft. and 210-230 ft. Gravel pack? Yes Size range of material 12" Down		
			11. Static water level: 69 ft. below land surface Date 9-5-75 mo./day/yr.		
			12. Pumping level below land surfaces: 79 ft. after 2 hrs. pumping 776 g.p.m. 87 ft. after 1 hrs. pumping 1306 g.p.m. Estimated maximum yield 1300 g.p.m.		
			13. Water sample submitted: <input type="checkbox"/> Yes <input checked="" type="checkbox"/> No Date <input type="checkbox"/>		
			14. Well head completion: <input type="checkbox"/> Pitless adapter 12 Inches above grade		
			15. Well grouted? Yes With: <input checked="" type="checkbox"/> Neat cement <input type="checkbox"/> Bentonite <input type="checkbox"/> Concrete Depth: From 0 ft. to 10 ft.		
			16. Nearest source of possible contamination: ft. <input type="checkbox"/> Direction <input type="checkbox"/> Type N/A Well disinfected upon completion? Yes <input checked="" type="checkbox"/> No <input type="checkbox"/>		
			17. Pump: Manufacturer's name Peerless - F M C Model number 05287 HP 100 Volts <input type="checkbox"/> Length of drop pipe 160 ft. capacity 1300 g.p.m. Type: <input type="checkbox"/> Submersible <input checked="" type="checkbox"/> Turbine <input type="checkbox"/> Jet <input type="checkbox"/> Reciprocating <input type="checkbox"/> Centrifugal <input type="checkbox"/> Other		
18. Elevation:	19. Remarks: USED CASING		20. Water well contractor's certification: This well was drilled under my jurisdiction and this report is true to the best of my knowledge and belief. Minter-Wilson Drilling 208 Business name <input type="checkbox"/> Address Box A, Garden City, KS <input type="checkbox"/> Signed <input type="checkbox"/> Authorized representative <input type="checkbox"/> Date <input type="checkbox"/>		

Professionals

MINTER-WILSON DRILLING CO.

INCORPORATED

and Domes
Water Systems
Complete Install
and Repair

Phone 276 8269

P. O. Box 493

GARDEN CITY, KANSAS 67846

Verlin Koehn
Gray County

2-8-74

Test # 3

Location: $\frac{1}{2}$ East from Test # 2 on pivot

0	5	Top soil
5	20	Fine sand
20	40	Brown clay
40	98	Med. sand & coarse gravel (Loose)
98	105	Fine to med. sand & gravel with streaks of brown clay
105	125	Med. sand & gravel (Loose)
125	140	Med. coarse gravel (Loose)
140	173	Brown sandy clay
173	222	Fine to med. sand & gravel (Loose)
222	230	Brown clay with streaks of gravel (Hard)
230	289	Brown sandy clay
289	298	Brown clay with yellow clay (Hard)
298	305	Shale

Lost circulation at 87 feet