

USE TYPEWRITER OR BALL POINT PEN-PRESS FIRMLY, PRINT CLEARLY.


T R EW sec 1/4 1/4 1/4 No.

WATER WELL RECORD
KSA 82a-1201-1215

Kansas State Dept. Of Health
(Water Well Contractors)
Forbes-Bldg. 740
Topeka, Kansas 66620

1 Location of well: County GRAY Township name INGALLS Fraction NW 1/4 Section number 36 Town number 26 Range number 30

Distance and direction from nearest town or city: CHARLSTON-KAN
7 3/4 MI. SOUTH 1/4 EAST
Street address of well location if in city: _____
3 Owner of well: E.R. AMEND
Address: _____

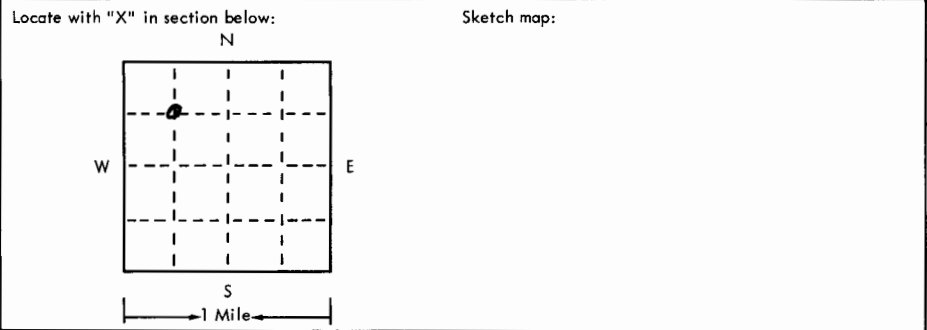

4 Well depth: 245 ft. Date of completion _____
Well diameter 28 in.
5 Cable tool Rotary Driven Dug
 Hollow rod Jetted Bored Reverse rotary
6 Use: Domestic Public supply Industry
 Irrigation Air conditioning Commercial
 Test well
7 Casing: Material STEEL Height: above/below
Threaded Welded Surface 8 in.
Diam. _____ Weight _____ lbs./ft. _____
16 in. to 245 ft. depth Drive shoe? Yes No
_____ in. to _____ ft. depth

2	Type and color of material	From	To
	Surface	0	2
	Silty Clay	2	8
	Fine sand	8	26
	Clay + Fine sand	26	53
	Sand & gravel	53	104
	Clay	104	110
	med Sand & small gravel	110	132
	Caliche	132	142
	Fine sand & clay layers	142	161
	med sand & gravel	161	166
	Clay	166	170
	med. sand	170	181
	Clay	181	184
	Sand & gravel	184	201
	Clay	201	232
	Sand & gravel	232	243

8 Screen: Manufacturer WABROWN
Type BRIDGE Dia. 14
Slot/gauze 8 Length _____
Set between _____ ft. and _____ ft. _____
Fittings: _____
Gravel pack Yes No Size range of material 1/2 in DOWN

9 Static water level: 84 ft. below land surface Date _____
10 Pumping level below land surfaces:
180 ft. after 1 hrs. pumping 1400 g.p.m.
_____ ft. after _____ hrs. pumping _____ g.p.m.
Estimated maximum yield 1400 g.p.m.

11 Water sample submitted:
 Yes No Date _____

12 Well head completion:
 Pitless adapter Inches above grade

13 Well grouted? Yes No
 Neat cement Bentonite CEMENT
Depth: From 0 ft. to 10 ft.

14 Nearest source of possible contamination: NONE
ft. _____ Direction _____ Type _____
Well disinfected upon completion? Yes No

15 Pump: Not installed
Manufacturer's name WLR
Model number _____ HP 7.5 Volts 440
Length of drop pipe 170 ft. capacity 700 g.p.m.
Type:
 Submersible Turbine
 Jet Reciprocating
 Centrifugal Other

16 Remarks: elevation _____

Topography:
 Hill
 Slope
 Upland
 Valley

17 Water well contractor's certification:
This well was drilled under my jurisdiction and this report is true to the best of my knowledge and belief.

J. JOHNSON DRILLING CO
Business name License No. _____
Address DODGE CITY KAN-183
Signed J. Johnson Date 10-31-75
Authorized representative

26 30 W 36 NW