


1	LOCATION OF WATER WELL:	Fraction	Section Number	Township Number	Range Number
County:	Finney	SE $\frac{1}{4}$ SW $\frac{1}{4}$ NE $\frac{1}{4}$	30	T 26 S	R 32 E ^(W)

Distance and direction from nearest town or city street address of well if located within city? **From south side of Garden City, 14 miles south, 1 mile east, 2650 ft. north, and 1485 ft. west.**

2	WATER WELL OWNER:	Forrest Crouse	
	RR#, St. Address, Box # :	695 E. Craft Road	Board of Agriculture, Division of Water Resources
	City, State, ZIP Code :	Garden City, Kansas 67846	Application Number: 33052

3 LOCATE WELL'S LOCATION WITH 4 DEPTH OF COMPLETED WELL 360 ft. ft. ELEVATION:

AN "X" IN SECTION BOX: Depth(s) Groundwater Encountered 1 ft. 2 ft. 3 ft.

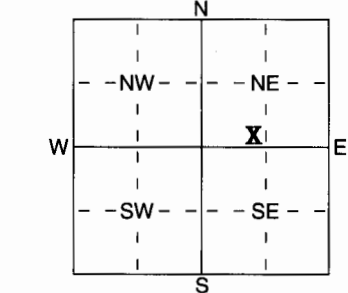

WELL'S STATIC WATER LEVEL 226 ft. below land surface measured on mo/day/yr July 1, 2004

Pump test data: Well water was _____ ft. after _____ hours pumping _____ gpm

Est. Yield _____ gpm: Well water was _____ ft. after _____ hours pumping _____ gpm

WELL WATER TO BE USED AS:

1 Domestic	3 Feedlot	5 Public water supply	8 Air conditioning	11 Injection well
2 Irrigation	4 Industrial	6 Oil field water supply	9 Dewatering	12 Other (Specify below)
		7 Domestic (lawn & garden)	10 Monitoring well	

Was a chemical/bacteriological sample submitted to Department? Yes No; If yes, mo/day/yr sample was submitted _____

Water Well Disinfected? Yes No

5	TYPE OF BLANK CASING USED:		5 Wrought iron	8 Concrete tile	CASING JOINTS: Glued Clamped Welded X Threaded
	① Steel	3 RMP (SR)	6 Asbestos-Cement	9 Other (specify below)	
	2 PVC	4 ABS	7 Fiberglass	

Blank casing diameter **16** in. to **275** ft., Dia in. to ft., Dia in. to ft.
Casing height above land surface **12** in., weight **42.05** lbs./ft. Wall thickness or gauge No. **.250**

TYPE OF SCREEN OR PERFORATION MATERIAL:

1 Steel	3 Stainless Steel	5 Fiberglass	7 PVC	10 Asbestos-Cement
2 Brass	4 Galvanized Steel	6 Concrete tile	8 RMP (SR)	11 Other (Specify)
			9 ABS	12 None used (open hole)

SCREEN OR PERFORATION OPENINGS ARE:

1 Continuous slot	3 Mill slot	5 Gauzed wrapped	8 Saw cut	11 None (open hole)
2 Louvered shutter	4 Key punched	6 Wire wrapped	9 Drilled holes	
		7 Torch cut	10 Other (specify)	ft

SCREEN-PERFORATED INTERVALS:	From <u>275</u> ft. to <u>360</u> ft.	From <u> </u> ft. to <u> </u> ft.	From <u> </u> ft. to <u> </u> ft.
	From <u> </u> ft. to <u> </u> ft.	From <u> </u> ft. to <u> </u> ft.	From <u> </u> ft. to <u> </u> ft.
GRAVEL PACK INTERVALS:	From <u>20</u> ft. to <u>360</u> ft.	From <u> </u> ft. to <u> </u> ft.	From <u> </u> ft. to <u> </u> ft.
	From <u> </u> ft. to <u> </u> ft.	From <u> </u> ft. to <u> </u> ft.	From <u> </u> ft. to <u> </u> ft.

6	GROUT MATERIAL:	1 Neat cement	2 Cement grout	3 Bentonite	4 Other
	Grout Intervals: From	0	ft to 20	ft From	ft to

What is the nearest source of possible contamination:

1 Septic tank	4 Lateral lines	7 Pit privy	10 Livestock pens	14 Abandoned water well
2 Sewer lines	5 Cess pool	8 Sewage lagoon	11 Fuel storage	15 Oil well/Gas well
3 Watertight sewer lines	6 Seepage pit	9 Feedyard	12 Fertilizer storage	16 Other (specify below)
			13 Insecticide storage	

Direction from well? **Northeast** How many feet? **30 ft. north, 125 ft. east**

[illegible]

7 CONTRACTOR'S OR LANDOWNER'S CERTIFICATION: This water well was (1) constructed, (2) reconstructed, or (3) plugged under my jurisdiction and was completed on (mo/day/year) July 1, 2004 and this record is true to the best of my knowledge and belief. Kansas Water Well Contractor's Licence No. 208. This Water Well Record was completed on (mo/day/yr) July 2, 2004 under the business name of Minter-Wilson Drilling Co. by signature Andrea Rome

*The
Professionals*

MINTER-WILSON DRILLING CO.

INCORPORATED

Irrigation
and Domestic
Water Systems
Complete Installation
and Repairing

Phone 276-8269

P.O. Box A

GARDEN CITY, KANSAS 67846

Frosty Crouse
Finney County
5/7/04

Location: E $\frac{1}{2}$ 30-26-32 - South on Hwy. 83 to T.V. Road, 1 mile south,
1 mile east, $\frac{1}{2}$ mile south & $\frac{1}{2}$ mile west
- From well - 125 ft. west & 30 ft. south

Static Water Level - 230 ft.

Test #1

0' to 1' - Top soil
1' to 15' - Brown clay
15' to 38' - Brown sandy clay
38' to 59' - Brown clay
59' to 68' - Fine to medium sand & gravel
68' to 109' - Fine to medium sand & gravel with some coarse
109' to 158' - Brown clay
158' to 170' - Fine to medium sand & gravel - 10% clay
170' to 181' - Brown clay
181' to 191' - Fine to medium sand & gravel
191' to 217' - Brown clay
217' to 278' - Fine to medium sand & gravel
278' to 300' - Fine to medium sand with clay streaks
300' to 343' - Fine to medium sand & gravel
343' to 425' - Brown clay
425' to 467' - Brown flaky clay
467' to 473' - Brown clay with brown rock 30%
473' to 505' - Brown clay
505' to 512' - Yellow clay
512' to 515' - Shale