


1 LOCATION OF WATER WELL: COUNTY: 028 FINNEY	Fraction NW 1/4 NW 1/4 SW 1/4	Section Number 10	Township Number T 26 S	Range Number R 32 W
---	----------------------------------	----------------------	---------------------------	------------------------

Distance and direction from nearest town or city street address of well if located within city?
FROM GARDEN CITY; APPX 10 1/2 MILES SOUTH & 3 MILES EAST

2 WATER WELL OWNER: **RICHARD LIGHTNER**
 RR#, St. Address, Box # : **5215 E. PLYMELL ROAD**
 City, State, ZIP code : **GARDEN CITY, KS 67846-8961**
 Board of Agriculture, Division of Water Resources
 Application Number: _____

3 LOCATE WELL'S LOCATION WITH
 AN "X" IN SECTION BOX:

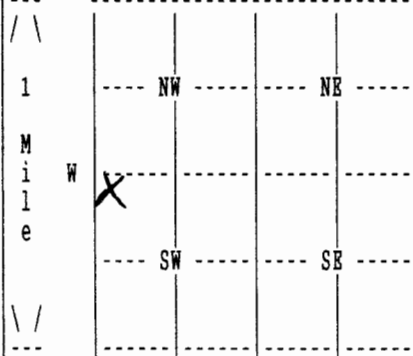

4 DEPTH OF COMPLETED WELL 350 ELEVATION: 0
 Depth(s) Groundwater Encountered 1. 0 ft. 2. 0 ft. 3. 0 ft.

WELL'S STATIC WATER LEVEL 225 ft. below land surface measured on mo/day/yr 07/18/05
 Pump test data: Well water was 0 ft. after 0 hours pumping 0 gpm

Estimated Yield 0 gpm: Well water was 0 ft. after 0 hours pumping 0 gpm

Bore Hole Diameter 9 7/8 in. to 350 ft., and in. to 0 ft.

WELL WATER TO BE USED AS: 01 DOMESTIC

Was a chemical/bacteriological sample submitted to department? No ;
 If yes, mo/day/yr sample was submitted Water well disinfected? Yes

5 TYPE OF BLANK CASING USED: 02 PVC CASING JOINTS: **OTHER CASING JNT - CERTILOCK**
 Blank casing diameter 5 in. to 350 ft., Dia in. to 0 ft., Dia in. to 0 ft.
 Casing height above land surface 12 in., weight 3 lbs/ft. Wall thickness or gauge No. .265
 TYPE OF SCREEN OR PERFORATION MATERIAL: 07 PVC
 SCREEN OR PERFORATION OPENINGS ARE: 01 CONT. SLOT

SCREEN PERFORATED INTERVALS:	From 290 ft. to 350 ft.,	From 0 ft. to 0 ft.
	From 0 ft. to 0 ft.,	From 0 ft. to 0 ft.
GRAVEL PACK INTERVALS:	From 25 ft. to 350 ft.,	From 0 ft. to 0 ft.
	From 0 ft. to 0 ft.,	From 0 ft. to 0 ft.

6 GROUT MATERIAL 03 BENTONITE

Grout Intervals: From 0 ft. to 25 ft., From 0 ft. to 0 ft., From 0 ft. to 0 ft.

What is the nearest source of possible contamination: **NONE OBSERVED**

Direction from well?

How many feet? 0

FROM	TO	LITHOLOGIC LOG	FROM	TO	PLUGGING INTERVALS
0	2	02 SILT			
2	20	01 CLAY 05 SAND			
20	63	05 SAND 11 GRAVEL 28 ROCK			
63	75	07 FINE SAND 08 MEDIUM SAND			
75	82	01 CLAY			
82	89	07 FINE SAND 08 MEDIUM SAND			
89	108	01 CLAY 20 LIMESTONE			
108	128	04 SANDY CLAY 05 SAND			
128	154	05 SAND 01 CLAY			
154	161	01 CLAY 05 SAND			

7 CONTRACTOR'S OR LANDOWNER'S CERTIFICATION: This water well was Constructed under my jurisdiction and was completed on (mo/day/year) 07/13/05 and this record is true to the best of my knowledge and belief. Kansas
 Water Well Contractor's License No. 145 This Water Well Record was completed on (mo/day/yr) 10/06/05
 under the business name of **HENKLE DRILLING & SUPPLY** by (signature)

1 LOCATION OF WATER WELL: COUNTY: 028 FINNEY	Fraction NW 1/4 NW 1/4 SW 1/4	Section Number 10	Township Number T 26 S	Range Number R 32 W
---	----------------------------------	----------------------	---------------------------	------------------------

2 WATER WELL OWNER: RR#, St. Address, Box # : City, State, ZIP code :	RICHARD LIGHTNER 5215 E. PLYMELL ROAD GARDEN CITY, KS 67846-8961	Board of Agriculture, Division of Water Resources Application Number:
---	--	--

FROM	TO	LITHOLOGIC LOG
161	187	01 CLAY 20 LIMESTONE 05 SAND
187	195	05 SAND 01 CLAY
195	257	01 CLAY
257	270	05 SAND 13 FINE GRAVEL
270	277	01 CLAY
277	287	05 SAND
287	300	07 FINE SAND 01 CLAY
300	319	05 SAND
319	330	01 CLAY 05 SAND
330	345	07 FINE SAND
345	380	01 CLAY 05 SAND
380	400	01 CLAY

7 CONTRACTOR'S OR LANDOWNER'S CERTIFICATION: This water well was Constructed under my jurisdiction and was completed on (mo/day/year) 07/13/05 and this record is true to the best of my knowledge and belief. Kansas Water Well Contractor's License No. 145 This Water Well Record was completed on (mo/day/yr) 10/06/05 under the business name of HENKLE DRILLING & SUPPLY by (signature) <i>Burn J. Richmond</i>
