


1 LOCATION OF WATER WELL: Fraction Near Center Section Number 33 Township Number T 26 S Range Number 32 E W
 County: FINNEY $\frac{1}{4}$ $\frac{1}{4}$ SW $\frac{1}{4}$

Street/Rural Address of Well Location; if unknown, distance & direction from nearest town or intersection: If at owner's address, check here GARDEN CITY- 15 M S TO COUNTY
LINE, 3 M E, 1,320 FT. N & 3,960 FT. W
2 WATER WELL OWNER: EDNA E COLLINGWOOD
 RR#, St. Address, Box #: TRUST, PO BOX 1184
 City, State ZIP Code: HUTCHINSON, KS 67504

Global Positioning Systems (GPS) information:
 Latitude: _____ (in decimal degrees)
 Longitude: _____ (in decimal degrees)
 Elevation: _____
 Datum: WGS84, NAD83, NAD27
 Collection Method:
 GPS unit (Make/Model: _____)
 Digital Map/Photo, Topographic Map, Land Survey
 Est. Accuracy: < 3 m, 3-5 m, 5-15 m, > 15 m

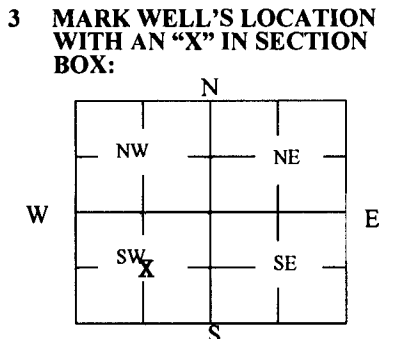

4 DEPTH OF WELL 328 ft.
 WELL'S STATIC WATER LEVEL 275 ft.
 WELL WAS USED AS:
 Domestic Public Water Supply Dewatering
 Irrigation Oil Field Water Supply Monitoring
 Feedlot Domestic (Lawn & Garden) Injection Well
 Industrial Air Conditioning Other _____
 Was a chemical/bacteriological sample submitted to Department? Yes No

5 TYPE OF BLANK CASING USED:
 Steel RMP (SR) Wrought Fiberglass Other (Specify below)
 PVC ABS Asbestos-Cement Concrete Tile
 Blank casing diameter 16 in. Was casing pulled? Yes No If yes, how much 3 FT.
 Casing height above or below land surface 36 in. **Below**

6 GROUT PLUG MATERIAL: Neat cement Cement grout Bentonite Other _____
 Grout Plug Intervals: From 3 ft. to 275 ft., From _____ ft. to _____ ft., From _____ to _____ ft.
 What is the nearest source of possible contamination:
 Septic tank Seepage pit Fuel Storage Other (specify below)
 Sewer lines Pit privy Fertilizer storage N/A
 Watertight sewer lines Sewage lagoon Insecticide storage
 Lateral lines Feedyard Abandoned water well Direction from well? _____
 Cess pool Livestock pens Oil well/Gas well How many feet? _____

FROM	TO	PLUGGING MATERIALS	FROM	TO	PLUGGING MATERIALS
0'	3'	TOP SOIL			
3'	275'	CEMENT GROUT			
275'	328'	CHLORINATED GRAVEL			

7 CONTRACTOR'S OR LANDOWNER'S CERTIFICATION: This water well was plugged under my jurisdiction and was completed on (mo/day/year) 10-7-14 and this record is true to the best of my knowledge and belief. Kansas Water Well Contractor's License No. 208. This Water Well Record was completed on (mo/day/year) 10-13-14 under the business name of MINTER-WILSON DRILLING CO., INC. by (signature) NOA KELLER

INSTRUCTIONS: Use typewriter or ballpoint pen. Please press firmly and print clearly. Please fill in blanks, underline or circle the correct answers. Send one copy to Kansas Department of Health and Environment, Bureau of Water, Geology Section, 1000 SW Jackson St., Ste. 420, Topeka, Kansas 66612-1367. Telephone: 785/296-5524. Send one to Water Well Owner and retain one for your records. Visit us at <http://www.kdheks.gov/waterwell/index.html>.