



WATER WELL RECORD

Form WWC-5

1327133


Division of Water Resources App. No.

- Original Record Correction Change in Well Use

Well ID

1 LOCATION OF WATER WELL: County: Fraction Section Number Township Number Range Number

2 WELL OWNER: Last Name: Business: Address: City: State: ZIP: Street or Rural Address where well is located

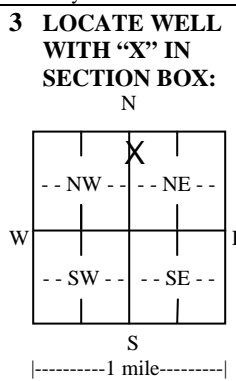

4 DEPTH OF COMPLETED WELL: Depth(s) Groundwater Encountered: WELL'S STATIC WATER LEVEL: Pump test data: Estimated Yield: Bore Hole Diameter:

5 Latitude: Longitude: Datum: Source for Latitude/Longitude: GPS Land Survey Topographic Map Online Mapper

6 Elevation: Source: Land Survey GPS Topographic Map Other

7 WELL WATER TO BE USED AS: 1. Domestic 2. Irrigation 3. Feedlot 4. Industrial 5. Public Water Supply 6. Dewatering 7. Aquifer Recharge 8. Monitoring 9. Environmental Remediation 10. Oil Field Water Supply 11. Test Hole 12. Geothermal 13. Other

Was a chemical/bacteriological sample submitted to KDHE? Water well disinfected?

8 TYPE OF CASING USED: CASING JOINTS: Casing diameter: Casing height above land surface: Weight: Wall thickness or gauge No.

TYPE OF SCREEN OR PERFORATION MATERIAL: SCREEN OR PERFORATION OPENINGS ARE: SCREEN-PERFORATED INTERVALS: GRAVEL PACK INTERVALS:

9 GROUT MATERIAL: Grout Intervals: Nearest source of possible contamination: Direction from well? Distance from well?

Table with columns: 10 FROM TO LITHOLOGIC LOG FROM TO LITHO. LOG (cont.) or PLUGGING INTERVALS

Notes:

11 CONTRACTOR'S OR LANDOWNER'S CERTIFICATION: This water well was constructed, reconstructed, or plugged under my jurisdiction and was completed on (mo-day-year) and this record is true to the best of my knowledge and belief.

| | |
|------------|-------------------------------------|
| Form | WWC5 |
| Contractor | Hydro Resources Mid Continent, Inc. |
| Well Owner | |
| Doc ID | 1327133 |

Litholgy

| From | To | LithologicLog |
|------|-----|--|
| 0 | 2 | top soil |
| 2 | 30 | fine sand |
| 30 | 37 | brown sandy clay |
| 37 | 52 | fine sand |
| 52 | 56 | brown sandy clay |
| 56 | 109 | sand fine to med coarse small med large gravel |
| 109 | 131 | brown sandy clay w/ some sand beds |
| 131 | 138 | sand fine to med coarse small gravel |
| 138 | 162 | brown clay w/ few sand strips |
| 162 | 174 | sand fine to med coarse |
| 174 | 181 | brown sandy clay |
| 181 | 199 | sand fine to med coarse |
| 199 | 204 | brown sandy clay |
| 204 | 223 | sand fine to med coarse small gravel |
| 223 | 254 | sand fine to med coarse w/ many clay ledges |
| 254 | 267 | blue clay |
| 267 | 327 | sand fine to med coarse small gravel |
| 327 | 338 | brown sandy clay |
| 338 | 358 | sand fine to med w/ many clay ledges |

| | |
|------------|-------------------------------------|
| Form | WWC5 |
| Contractor | Hydro Resources Mid Continent, Inc. |
| Well Owner | |
| Doc ID | 1327133 |

Litholgy

| From | To | LithologicLog |
|------|-----|--|
| 358 | 380 | sand fine to med coarse |
| 380 | 400 | sand fine few med w/ some clay ledges |
| 400 | 410 | brown clay w/ some sand stips |
| 410 | 424 | fine sand |
| 424 | 439 | sand fine to med |
| 439 | 450 | brown sluffy clay |
| 450 | 470 | brown sluffy clay w some sand strips |
| 470 | 490 | sand fine to med coarse w/ some brown & tan rock |
| 490 | 503 | brown sluffy clay |
| 503 | 511 | soapstone |
| 511 | 528 | soapstone & sandstone |
| 528 | 542 | brown rock & sandstone |
| 542 | 545 | soapstone |
| 545 | 560 | shale |