

WATER WELL PLUGGING RECORD

Form WWC-5P

KSA 82a-1212

ID NO.

14929

1 LOCATION OF WATER WELL: Fraction $\frac{1}{4}$ SE $\frac{1}{4}$ SW $\frac{1}{4}$ SE $\frac{1}{4}$ Section Number 13 Township Number T 26 S Range Number 33 ☐ E ☒ W

Street/Rural Address of Well Location; if unknown, distance & direction from nearest town or intersection: If at owner's address, check here ☐ 2 mi South of Plymell, KS
114 m: West

Global Positioning Systems (GPS) information:

Latitude: 37° 46.843 (in decimal degrees)

Longitude: 100° 52.625 (in decimal degrees)

Elevation:


Datum: ☐ WGS84, ☐ NAD83, ☐ NAD27

Collection Method:

☒ GPS unit (Make/Model: _____)☐ Digital Map/Photo, ☐ Topographic Map, ☐ Land SurveyEst. Accuracy: ☐ < 3 m, ☐ 3-5 m, ☐ 5-15 m, ☐ > 15 m

2 WATER WELL OWNER: Vijahn Inc
RR#, St. Address, Box #: 2098 Bayou Des bonne Rd
City, State ZIP Code: Natchitoches, La 71457

3 MARK WELL'S LOCATION WITH AN "X" IN SECTION BOX:

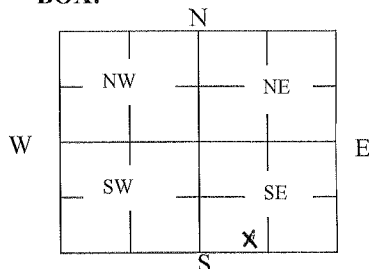

4 DEPTH OF WELL 350 ft.

WELL'S STATIC WATER LEVEL 285.5 ft

WELL WAS USED AS:

☐ Domestic
☒ Irrigation
☐ Feedlot
☐ Industrial

☐ Public Water Supply
☐ Oil Field Water Supply
☐ Domestic (Lawn & Garden)
☐ Air Conditioning

☐ Dewatering
☐ Monitoring
☐ Injection Well
☐ Other _____

Was a chemical/bacteriological sample submitted to Department? Yes ☐ No ☐

5 TYPE OF BLANK CASING USED:

☒ Steel
☐ PVC

☐ RMP (SR)
☐ ABS

☐ Wrought
☐ Asbestos-Cement

☐ Fiberglass
☐ Concrete Tile

☐ Other (Specify below) _____

Blank casing diameter 16 in. Was casing pulled? Yes ☒ No ☐ If yes, how much 60"
Casing height above or below land surface Below 60" in.

6 GROUT PLUG MATERIAL: ☐ Neat cement ☒ Cement grout ☐ Bentonite ☐ Other _____

Grout Plug Intervals: From 10' ft. to 5' ft., From _____ ft. to _____ ft., From _____ to _____ ft.

What is the nearest source of possible contamination:

☐ Septic tank
☐ Sewer lines
☐ Watertight sewer lines
☐ Lateral lines
☐ Cess pool

☐ Seepage pit
☐ Pit privy
☐ Sewage lagoon
☐ Feedyard
☐ Livestock pens

☐ Fuel Storage
☐ Fertilizer storage
☐ Insecticide storage
☐ Abandoned water well
☐ Oil well/Gas well

☒ Other (specify below)

None observed

Direction from well? _____

How many feet? _____

FROM	TO	PLUGGING MATERIALS	FROM	TO	PLUGGING MATERIALS
350'	265'	Chlorinated Sand	265'	10'	Sandy loam soil
10'	5'	3000 PSI Concrete	5'	0'	Cutoff casing & backfilled

7 CONTRACTOR'S OR LANDOWNER'S CERTIFICATION: This water well was plugged under my jurisdiction and was completed on (mo/day/year) 3-1-13 and this record is true to the best of my knowledge and belief. Kansas Water Well Contractor's License No. _____. This Water Well Record was completed on (mo/day/year) 3-27-13 under the business name of _____ by (signature) _____

INSTRUCTIONS: Use typewriter or ballpoint pen. Please press firmly and print clearly. Please fill in blanks, underline or circle the correct answers. Send top three copies to Kansas Department of Health and Environment, Bureau of Water, Geology Section, 1000 SW Jackson St., Ste. 420, Topeka, Kansas 66612-1367. Telephone: 785/296-5524. Send one to Water Well Owner and retain one for your records. Visit us at <http://www.kdheks.gov/waterwell/index.html>.

Check one: ☐ White Copy ☐ Blue Copy ☐ Pink Copy

DRILLERS TEST LOG

CUSTOMER'S NAME J. H. Johnson DATE Aug. 4, 1954
 ADDRESS Chicago, Ill. TEST NO 1
 COUNTY Finney QUARTER SE 4 SECTION NO 13 TOWNSHIP 26 RANGE 33

DRILLED FOOTAGE			DESCRIPTION OF STRATA	INDICATE TEST LOCATION BY AN X	
FROM	PAY	TO			
0		2	topsoil		
2		4	subsoil		
4		9	silt clay		
9		21	clay		
21		39	silt sand - small clay streaks		
39		58	clay - limey		
58		64	caliche		
64		95	sand - fine to gravel - fairly loose, small rough streaks		
95		104	clay - yellow - limey streaks		
104		112	sand - fine with clay shells - small rock shells		
112		126	clay - sandy - small rock shells, some imbedded gravel		
126	135	138	sand - fine to coarse, clay streaks		
138		142	cemented sand - hard		
142		147	sand - fine - clay streaks		
147		153	clay - sandy with fine sand - out		
153		170	sand - fine to coarse - clay shells		
170		184	sand - fine to med. fine, small clay shells		
184		206	clay - sandy		
206		224	sand - fine with clay		
224		233	clay		
233	250	262	sand - fine to coarse - clay streaks		
262	260	266	clay		
266	265	278	sand - fine to med. coarse		
278	275	294	sand - very fine - loose out		
294		205	clay - mushy - sandy		
205		306	rock shell		
306	10'	317	sand - fine to coarse		
317		324	clay - small coarse sand streaks		
324		325	rock shell - hard		
325	5'	332	sand & gravel - clay shells		
332		333	rock shell - hard		
333		335	clay		
335		336	rock shell		
336	10'	348	sand - fine to coarse - clay streaks		
348		356	clay		
356	3	359	sand - fine to coarse		
359		362	clay		
362		364	sand - fine to coarse		
364		372	clay		

STATIC WATER LEVEL: _____

REMARKS: _____

HOBKLE and CO. Water Well Supplies - Drilling - Irrigation Headquarters
 Box 634 Garden City, Kansas Phone 3266

Pumps
 Well Casing
 Water Systems

Tanks
 Sheet Metal
 Products

[illegible]

Tanks
Sheet Metal
Products