

WATER WELL RECORD

Form WWC-5


Division of Water Resources App. No.

26,115

1 LOCATION OF WATER WELL: County: FINNEY Fraction 1/4 SE 1/4 NW 1/4 SW 1/4 Section Number 1 Township No. T 26 S Range Number R 33 [] E [X] W

Street/Rural Address of Well Location; if unknown, distance & direction from nearest town or intersection: If at owner's address, check here []. GARDEN CITY-10 MILES SOUTH ON HWY. 83 TO PLYMELL RD, 1,344 FT. NORTH & 4,195 FT. WEST Global Positioning System (GPS) information: Latitude: ... Longitude: ... Elevation: ... Datum: [] WGS 84, [] NAD 83, [] NAD 27 Collection Method: [] GPS unit (Make/Model: ...) [] Digital Map/Photo, [] Topographic Map, [] Land Survey Est. Accuracy: [] <3 m, [] 3-5 m, [] 5-15 m, [] >15 m

2 WATER WELL OWNER: RUTH RICHARDS TRUST #1 RR#, Street Address, Box #: 11235 SOUTH FORK ROAD City, State, ZIP Code : GARDEN CITY, KS 67846

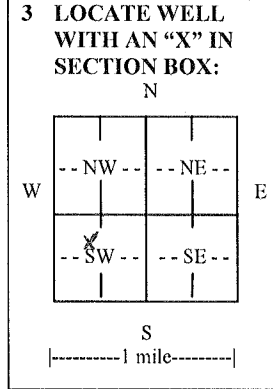

3 LOCATE WELL WITH AN "X" IN SECTION BOX: 4 DEPTH OF COMPLETED WELL 460 ft. Depth(s) Groundwater Encountered (1) ... (2) ... (3) ... WELL'S STATIC WATER LEVEL ... Pump test data: Well water was ... EST. YIELD ... Bore Hole Diameter 30 in. to 460 ft. and ... WELL WATER TO BE USED AS: [] Public water supply [] Geothermal [] Injection well [] Domestic [] Feedlot [] Oil field water supply [] Dewatering [] Other (Specify below) [X] Irrigation [] Industrial [] Domestic-lawn & garden [] Monitoring well Was a chemical/bacteriological sample submitted to Department? [] Yes [X] No If yes, mo/day/yr sample was submitted. Water well disinfected? [] Yes [X] No

5 TYPE OF CASING USED: [X] Steel [] PVC [] Other CASING JOINTS: [] Glued [] Clamped [] Welded [X] Threaded Casing diameter 16 in. to 260 ft., Diameter ... Casing height above land surface 12 in., Weight 42.05 lbs./ft., Wall thickness or gauge No. 250 TYPE OF SCREEN OR PERFORATION MATERIAL: [X] Steel [] Stainless Steel [] PVC [] Other (Specify) [] Brass [] Galvanized Steel [] None used (open hole) SCREEN OR PERFORATION OPENINGS ARE: [] Continuous slot [X] Mill slot [] Gauze wrapped [] Torch cut [] Drilled holes [] None (open hole) [] Louvered shutter [] Key punched [X] Wire wrapped [] Saw cut [] Other (specify) SCREEN-PERFORATED INTERVALS: From 260 ft. to 460 ft., From ... GRAVEL PACK INTERVALS: From 20 ft. to 185 ft., From 245 ft. to 460 ft., From ...

6 GROUT MATERIAL: [] Neat cement [X] Cement grout [] Bentonite [] Other Grout Intervals: From 0 ft. to 20 ft., From 185 ft. to 245 ft., From ... What is the nearest source of possible contamination: [] Septic tank [] Lateral lines [] Pit privy [] Livestock pens [] Insecticide storage [] Other (specify below) [] Sewer lines [] Cesspool [] Sewage lagoon [] Fuel storage [] Abandoned water well [] Watertight sewer lines [] Seepage pit [] Feedyard [] Fertilizer storage [] Oil well/gas well N/A Direction from well Distance from well

Table with columns: FROM, TO, LITHOLOGIC LOG, FROM, TO, LITHO. LOG (cont.) or PLUGGING INTERVALS. Row 1: SEE ATTACHED LOG

7 CONTRACTOR'S OR LANDOWNER'S CERTIFICATION: This water well was [X] constructed, [] reconstructed, or [] plugged under my jurisdiction and was completed on (mo/day/year) 7-15-14 and this record is true to the best of my knowledge and belief. Kansas Water Well Contractor's License No. 208 This Water Well Record was completed on (mo/day/year) 7-18-14 under the business name of MINTER-WILSON DRILLING CO., INC. by (signature) Anna Kellner

INSTRUCTIONS: Use typewriter or ball point pen. PLEASE PRESS FIRMLY and PRINT clearly. Please fill in blanks and check the correct answers. Send one copy to Kansas Department of Health and Environment, Bureau of Water, Geology Section, 1000 SW Jackson St., Suite 420, Topeka, Kansas 66612-1367. Telephone 785-296-5524. Send one copy to WATER WELL OWNER and retain one for your records. Include fee of \$5.00 for each constructed well. Visit us at http://www.kdheks.gov/waterwell/index.html

*The
Professionals*

MINTER-WILSON DRILLING CO.

INCORPORATED

Irrigation
and Domestic
Water Systems
Complete Installation
and Repairing

Phone 620-276-8269 • P.O. Box A • GARDEN CITY, KANSAS 67846

NAME MIKE DEEVER
COUNTY FINNEY
DATE 5-27-14

LOCATION: S 1/2 1-26-33 - PLYMELL - 1 MILE WEST, 1/4 MILE NORTH & 1/4 MILE EAST
- 300 FT. WEST OF PIVOT

STATIC WATER LEVEL -

TEST # 1

0' TO 2' - TOP SOIL
2' TO 31' - BROWN CLAY & BROWN SANDY CLAY
31' TO 72' - FINE TO MEDIUM SAND & GRAVEL - SOME COARSE
72' TO 90' - BROWN CLAY
90' TO 100' - BROWN SANDY CLAY
100' TO 110' - FINE TO MEDIUM SAND
110' TO 181' - BROWN SANDY CLAY
181' TO 200' - FINE TO MEDIUM SAND & GRAVEL
200' TO 230' - BROWN SANDY CLAY
230' TO 260' - BROWN CLAY WITH GRAVEL STREAKS
260' TO 279' - FINE TO MEDIUM SAND & GRAVEL - 10% CLAY
279' TO 290' - BROWN CLAY
290' TO 337' - FINE TO MEDIUM SAND & GRAVEL
337' TO 381' - FINE TO MEDIUM SAND & GRAVEL WITH CLAY STREAKS
381' TO 410' - BROWN CLAY
410' TO 422' - BROWN CLAY WITH GRAVEL MIXED
422' TO 455' - BROWN CLAY - SMALL STREAK OF GRAVEL
455' TO 464' - BROWN YELLOW CLAY
464' TO 470' - SHALE - HARD PULL DOWN