

County: Finney Fraction SE SE SE NE Sec. 25 T 26 S R 33 E(W)

CORRECTION(S) TO WATER WELL COMPLETION RECORD (WWC-5)

(to rectify lacking or incorrect information)

Owner: Phyllis Stacklejohn Trust

Location was listed as:

Section-Township-Range: Sec. 30 T26s R38W

Fraction (1/4 1/4 1/4): NW

Location changed to:

Sec. 25 T26s R33W

SE SE SE NE

Other changes: Initial statements: _____

Changed to: _____

Comments: _____

Verification method: KGS LEOWEB software, confirmed location using
KGS Interactive Map

initials: DRL date: 03-06-2017

Submitted by: Kansas Geological Survey, Data Resources Library, 1930 Constant Ave., Lawrence, KS 66047-3726
to: Kansas Dept of Health & Environment, Bureau of Water, 1000 SW Jackson, Suite 420, Topeka, KS 66612-1367.

WATER WELL PLUGGING RECORD Form WWC-5P

KSA 82a-1212

ID NO.

5752

1 **LOCATION OF WATER WELL:** Fraction 1/4 1/4 1/4 NW 1/4 Section Number 30 Township Number T 26 S Range Number 38 E W
 County: FINNEY

Street/Rural Address of Well Location; if unknown, distance & direction from nearest town or intersection: If at owner's address, check here From the intersection of Craft road &


Hwy 83; approx., 1/2 mile South & 80' East

Global Positioning Systems (GPS) information:
 Latitude: 37.75902 N (in decimal degrees)
 Longitude: 100.87046 W (in decimal degrees)
 Elevation: _____
 Datum: WGS84, NAD83, NAD27
 Collection Method:

2 **WATER WELL OWNER:** Phyllis Stracklejohn Trust
 RR#, St. Address, Box #: P.O. Box 1075
 City, State ZIP Code: Dighton Ks., 67839

GPS unit (Make/Model: Magellan eXplorist GC)
 Digital Map/Photo, Topographic Map, Land Survey
 Est. Accuracy: < 3 m, 3-5 m, 5-15 m, > 15 m

3 **MARK WELL'S LOCATION WITH AN "X" IN SECTION BOX:**

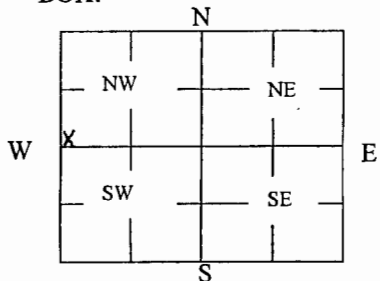

4 **DEPTH OF WELL** 425' ft.
WELL'S STATIC WATER LEVEL 310' ft.

WELL WAS USED AS:

- | | | |
|--|---|---|
| <input type="checkbox"/> Domestic | <input type="checkbox"/> Public Water Supply | <input type="checkbox"/> Dewatering |
| <input checked="" type="checkbox"/> Irrigation | <input type="checkbox"/> Oil Field Water Supply | <input type="checkbox"/> Monitoring |
| <input type="checkbox"/> Feedlot | <input type="checkbox"/> Domestic (Lawn & Garden) | <input type="checkbox"/> Injection Well |
| <input type="checkbox"/> Industrial | <input type="checkbox"/> Air Conditioning | <input type="checkbox"/> Other _____ |

Was a chemical/bacteriological sample submitted to Department? Yes No

5 **TYPE OF BLANK CASING USED:**

- Steel RMP (SR) Wrought Fiberglass Other (Specify below) _____
 PVC ABS Asbestos-Cement Concrete Tile

Blank casing diameter 16" in. Was casing pulled? Yes No If yes, how much 72"
 Casing height above or below land surface Below 72" in.

6 **GROUT PLUG MATERIAL:** Neat cement Cement grout Bentonite Other _____

Grout Plug Intervals: From 10' ft. to 6' ft., From _____ ft. to _____ ft., From _____ to _____ ft.

What is the nearest source of possible contamination:

- | | | | |
|---|---|---|---|
| <input type="checkbox"/> Septic tank | <input type="checkbox"/> Seepage pit | <input type="checkbox"/> Fuel Storage | <input checked="" type="checkbox"/> Other (specify below) |
| <input type="checkbox"/> Sewer lines | <input type="checkbox"/> Pit privy | <input type="checkbox"/> Fertilizer storage | <input type="checkbox"/> None Observed |
| <input type="checkbox"/> Watertight sewer lines | <input type="checkbox"/> Sewage lagoon | <input type="checkbox"/> Insecticide storage | |
| <input type="checkbox"/> Lateral lines | <input type="checkbox"/> Feedyard | <input type="checkbox"/> Abandoned water well | Direction from well? _____ |
| <input type="checkbox"/> Cess pool | <input type="checkbox"/> Livestock pens | <input type="checkbox"/> Oil well/Gas well | How many feet? _____ |

FROM	TO	PLUGGING MATERIALS	FROM	TO	PLUGGING MATERIALS
425'	310'	Chlorinated Road Sand	310'	10'	Oversized Rock w/Clay Chunks
10'	6'	3,000 PSI Concrete	6'	0'	Cut off casing & Backfilled

7 **CONTRACTOR'S OR LANDOWNER'S CERTIFICATION:** This water well was plugged under my jurisdiction and was completed on (mo/day/year) 12-22-2016 and this record is true to the best of my knowledge and belief. Kansas Water Well Contractor's License No. 145. This Water Well Record was completed on (mo/day/year) 12-22-2016 under the business name of Hydro Resources Mid Continent by (signature) Gary Clepper

INSTRUCTIONS: Use typewriter or ballpoint pen. Please press firmly and print clearly. Please fill in blanks, underline or circle the correct answers. Send top three copies to Kansas Department of Health and Environment, Bureau of Water, Geology Section, 1000 SW Jackson St., Ste. 420, Topeka, Kansas 66612-1367. Telephone: 785/296-5524. Send one to Water Well Owner and retain one for your records. Visit us at <http://www.kdheks.gov/waterwell/index.html>.

Check one: White Copy Blue Copy Pink Copy