

WATER WELL PLUGGING RECORD Form WWC-5P

KSA 82a-1212

ID NO.

22,577


1 LOCATION OF WATER WELL: County: FINNEY	Fraction ¼ NW ¼ SE ¼ SW ¼	Section Number 24	Township Number T 26 S	Range Number 34 ☐ E ☒ W
---	------------------------------	----------------------	---------------------------	---

Street/Rural Address of Well Location; if unknown, distance & direction from nearest town or intersection: If at owner's address, check here ☐ GARDEN CITY-13-1/3 M. S. ON HWY 83 TO CRAFT RD, 6 M. W., 1,320 Ft. N. & 3,700 Ft. W.

Global Positioning Systems (GPS) information:
 Latitude: _____ (in decimal degrees)
 Longitude: _____ (in decimal degrees)
 Elevation: _____
 Datum: ☐ WGS84, ☐ NAD83, ☐ NAD27
 Collection Method:
☐ GPS unit (Make/Model: _____)
☐ Digital Map/Photo, ☐ Topographic Map, ☐ Land Survey
 Est. Accuracy: ☐ < 3 m, ☐ 3-5 m, ☐ 5-15 m, ☐ > 15 m

2 WATER WELL OWNER: WHEATLAND ELECTRIC
 RR#, St. Address, Box #: PO BOX 230
 City, State ZIP Code: SCOTT CITY, KS 67871

3 MARK WELL'S LOCATION WITH AN "X" IN SECTION BOX:

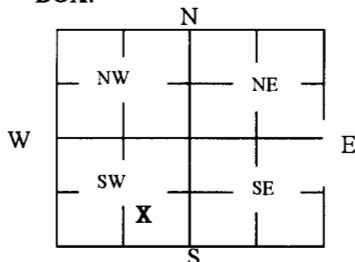

4 DEPTH OF WELL 345 ft.

WELL'S STATIC WATER LEVEL 270 ft

WELL WAS USED AS:

- | | | |
|--|---|---|
| ☐ Domestic | ☐ Public Water Supply | ☐ Dewatering |
| ☒ Irrigation | ☐ Oil Field Water Supply | ☐ Monitoring |
| ☐ Feedlot | ☐ Domestic (Lawn & Garden) | ☐ Injection Well |
| ☐ Industrial | ☐ Air Conditioning | ☐ Other _____ |

Was a chemical/bacteriological sample submitted to Department? Yes ☐ No ☒

5 TYPE OF BLANK CASING USED:

- ☒ Steel ☐ RMP (SR) ☐ Wrought ☐ Fiberglass ☐ Other (Specify below)
☐ PVC ☐ ABS ☐ Asbestos-Cement ☐ Concrete Tile

Blank casing diameter 16 in. Was casing pulled? Yes ☐ No ☒ If yes, how much _____
 Casing height above or below land surface 36 in. Below

6 GROUT PLUG MATERIAL: ☐ Neat cement ☒ Cement grout ☐ Bentonite ☐ Other _____

Grout Plug Intervals: From 3 ft. to 170 ft., From _____ ft. to _____ ft., From _____ to _____ ft.

What is the nearest source of possible contamination:

- | | | | |
|---|---|---|--|
| ☐ Septic tank | ☐ Seepage pit | ☐ Fuel Storage | ☐ Other (specify below) |
| ☐ Sewer lines | ☐ Pit privy | ☐ Fertilizer storage | N/A |
| ☐ Watertight sewer lines | ☐ Sewage lagoon | ☐ Insecticide storage | |
| ☐ Lateral lines | ☐ Feedyard | ☐ Abandoned water well | Direction from well? _____ |
| ☐ Cess pool | ☐ Livestock pens | ☐ Oil well/Gas well | How many feet? _____ |

FROM	TO	PLUGGING MATERIALS	FROM	TO	PLUGGING MATERIALS
0'	3'	TOP SOIL			
3'	270'	CEMENT GROUT			
270'	345'	CHLORINATED GRAVEL			

7 CONTRACTOR'S OR LANDOWNER'S CERTIFICATION: This water well was plugged under my jurisdiction and was completed on (mo/day/year) 5-20-11 and this record is true to the best of my knowledge and belief. Kansas Water Well Contractor's License No. 208. This Water Well Record was completed on (mo/day/year) 5-23-11 under the business name of MINTER-WILSON DRILLING CO., INC. by (signature) *Nora Keller*

INSTRUCTIONS: Use typewriter or ballpoint pen. Please press firmly and print clearly. Please fill in blanks, underline or circle the correct answers. Send top three copies to Kansas Department of Health and Environment, Bureau of Water, Geology Section, 1000 SW Jackson St., Ste. 420, Topeka, Kansas 66612-1367. Telephone: 785/296-5524. Send one to Water Well Owner and retain one for your records. Visit us at <http://www.kdheks.gov/waterwell/index.html>.

Check one: ☒ White Copy ☐ Blue Copy ☐ Pink Copy