

WATER WELL PLUGGING RECORD Form WWC-5P

KSA 82a-1212

ID NO.

25460

1 LOCATION OF WATER WELL: County: <u>Franklin</u>	Fraction $\frac{1}{4}$ $\frac{1}{4}$ $\frac{1}{4}$ NE $\frac{1}{4}$	Section Number <u>36</u>	Township Number T <u>26</u> S	Range Number <u>34</u> <input type="checkbox"/> E <input checked="" type="checkbox"/> W
--	--	-----------------------------	----------------------------------	--

Street/Rural Address of Well Location; if unknown, distance & direction from nearest town or intersection: If at owner's address, check here ☐ 3 mi. South of Plymouth
6 mi. Weston Craft Rd
1 3/4 mi. South on Ivanhoe Rd
1/4 mi. West

Global Positioning Systems (GPS) information:

Latitude: 37° 44.863 (in decimal degrees)Longitude: -100° 59.085 (in decimal degrees)

Elevation:

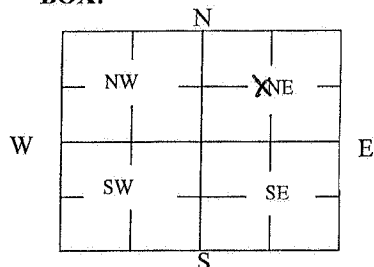
Datum: ☐ WGS84, ☐ NAD83, ☐ NAD27

Collection Method:

☒ GPS unit (Make/Model: _____)☐ Digital Map/Photo, ☐ Topographic Map, ☐ Land SurveyEst. Accuracy: ☐ < 3 m, ☐ 3-5 m, ☐ 5-15 m, ☐ > 15 m

2 WATER WELL OWNER: JBCircle Land
 RR#, St. Address, Box #: 9520 Hands Rd
 City, State ZIP Code: Garden City, KS 67846

3 MARK WELL'S LOCATION WITH AN "X" IN SECTION BOX:

4 DEPTH OF WELL 352 ft.WELL'S STATIC WATER LEVEL 274' 1/2 ft

WELL WAS USED AS:

☐ Domestic
☒ Irrigation
☐ Feedlot
☐ Industrial

☐ Public Water Supply
☐ Oil Field Water Supply
☐ Domestic (Lawn & Garden)
☐ Air Conditioning

☐ Dewatering
☐ Monitoring
☐ Injection Well
☐ Other _____
Was a chemical/bacteriological sample submitted to Department? Yes ☐ No ☐

5 TYPE OF BLANK CASING USED:

☒ Steel ☐ RMP (SR) ☐ Wrought ☐ Fiberglass ☐ Other (Specify below)
☐ PVC ☐ ABS ☐ Asbestos-Cement ☐ Concrete Tile

Blank casing diameter 16 in. Was casing pulled? Yes ☒ No ☐ If yes, how much 60"
 Casing height above or below land surface Below 60" in.

6 GROUT PLUG MATERIAL:

☐ Neat cement ☒ Cement grout ☐ Bentonite ☐ Other _____

Grout Plug Intervals: From 10' ft. to 5' ft., From _____ ft. to _____ ft., From _____ to _____ ft.

What is the nearest source of possible contamination:

☐ Septic tank
☐ Sewer lines
☐ Watertight sewer lines
☐ Lateral lines
☐ Cess pool

☐ Seepage pit
☐ Pit privy
☐ Sewage lagoon
☐ Feedyard
☐ Livestock pens

☐ Fuel Storage
☐ Fertilizer storage
☐ Insecticide storage
☐ Abandoned water well
☐ Oil well/Gas well
☒ Other (specify below)None observed

Direction from well? _____
 How many feet? _____

FROM	TO	PLUGGING MATERIALS	FROM	TO	PLUGGING MATERIALS
352	249	Chlorinated Sand	249	10	Sandy loam soil
10	5	3000 PSI Concrete	5	0	Cut off casing & backfilled

7 CONTRACTOR'S OR LANDOWNER'S CERTIFICATION: This water well was plugged under my jurisdiction and was completed on (mo/day/year) 4-24-13 and this record is true to the best of my knowledge and belief. Kansas Water Well Contractor's License No. _____. This Water Well Record was completed on (mo/day/year) 4-25-13 under the business name of _____ by (signature) Gregory J. [Signature]

INSTRUCTIONS: Use typewriter or ballpoint pen. Please press firmly and print clearly. Please fill in blanks, underline or circle the correct answers. Send top three copies to Kansas Department of Health and Environment, Bureau of Water, Geology Section, 1000 SW Jackson St., Ste. 420, Topeka, Kansas 66612-1367. Telephone: 785/296-5524. Send one to Water Well Owner and retain one for your records. Visit us at <http://www.kdheks.gov/waterwell/index.html>.

Check one: ☐ White Copy ☐ Blue Copy ☐ Pink Copy

KS GEO SURVEY

The Professionals

MINTER-WILSON DRILLING CO.
INCORPORATED

Water Systems
Complete Installation
and Repairing

Phone 276-8269 • P.O. Box 493 • GARDEN CITY, KANSAS 67846

ROGER BATCHELDER
FINNEY COUNTY
2-10-76

LOCATION NE 36-26-34
Center Of Quarter At Pivot Point

STATIC WATER LEVEL 126'

Circle #1

0	1	Top Soil
1	12	Fine Sand
12	20	Brown Clay
20	34	Fine Sand
34	50	Brown Sandy Clay
50	140	Fine To Med. Sand & Gravel (Loose)
140	148	Fine To Med. Sand & Gravel, Streaks Of Clay(10%)
148	215	Fine To Med. Sand & Gravel (Loose)
215	230	Fine To Med. Sand & Gravel, Streak Of Clay(10%)
230	277	Fine To Med. Sand & Gravel (Loose)
277	289	Fine To Med. Sand & Gravel, Streaks Of Clay & White Rock (10%)
289	291	Hard Streak
291	320	Fine To Med. Sand & Gravel (Loose)
320	330	Fine To Med. Sand & Gravel, Streaks Of Clay(10%)
330	352	Fine To Med. Sand & Gravel (Loose)
352	370	Brown Sandy Clay, Streaks Of Fine Sand (20)
370	403	Brown & White Sandy Clay
403	415	Fine Sand & Clay Mixture (50%) No Good
415	430	Brown Sandy Clay, White Clay, Yellow & Gray Clay

T.D. 252'
20' Screen

RECEIVED

MAY 2 8 1976

K8 GEC SURVEY