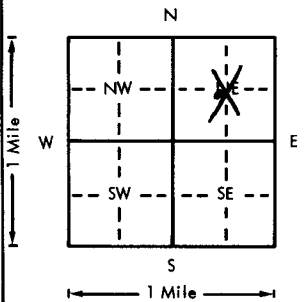


USE TYPEWRITER OR BALL
POINT PEN-PRESS FIRMLY,
PRINT CLEARLY.

WATER WELL RECORD
KSA 82a-1201-1215

Kansas Department of Health and
Environment-Division of Environment
(Water well Contractors)
Topeka, Kansas 66620

1. Location of well:		County KEARNY	Fraction NE 1/4SW 1/4NE 1/4	Section number 12	Township number T 26 S	Range number R 3 E
2. Distance and direction from nearest town or city: at Deerfield 1/2 east 10 south 1 3/4 east		3. Owner of well: Harold White R.R. or street: Lakin, Ks 67860 City, state, zip code:				
4. Locate with "X" in section below: 		Sketch map:		6. Bore hole dia. 26 in. Completion date 2-29-76 Well depth 352 ft.		
5. Type and color of material		From	To	7. <input type="checkbox"/> Cable tool <input type="checkbox"/> Rotary <input type="checkbox"/> Driven <input type="checkbox"/> Dug <input type="checkbox"/> Hollow rod <input type="checkbox"/> Jetted <input type="checkbox"/> Bored <input checked="" type="checkbox"/> Reverse rotary		
				8. Use: <input type="checkbox"/> Domestic <input type="checkbox"/> Public supply <input type="checkbox"/> Industry <input checked="" type="checkbox"/> Irrigation <input type="checkbox"/> Air conditioning <input type="checkbox"/> Stock <input type="checkbox"/> Lawn <input type="checkbox"/> Oil field water <input type="checkbox"/> Other		
				9. Casing: Material steel Height: 28 ft. Threaded <input type="checkbox"/> Welded <input checked="" type="checkbox"/> Surface 12 in. RMP <input type="checkbox"/> PVC <input type="checkbox"/> Weight 36.87 lbs./ft. Dia. 16 in. to 53 ft. depth Wall thickness: 1/2 in. or Dia. 16 in. to 53 ft. depth gage No. 250 219 MTC		
				10. Screen: Johnson Division Type Galv. Dia. 16" Slot/gauze 100 Length 20' Set between 270 ft. and 290 ft. Perf. 180-270 ft. and 290-352 ft. Gravel pack? yes Size range of material 1/2" down		
				11. Static water level: 81 ft. below land surface Date 2-7-76 mo./day/yr.		
				12. Pumping level below land surfaces: 208 ft. after 3 hrs. pumping 1100 g.p.m. 1100 ft. after 1 hrs. pumping 1100 g.p.m. Estimated maximum yield 1100 g.p.m.		
				13. Water sample submitted: Yes <input checked="" type="checkbox"/> No <input type="checkbox"/> Date		
				14. Well head completion: 12 inches above grade <input type="checkbox"/> Pitless adapter		
				15. Well grouted? yes With: <input type="checkbox"/> Neat cement <input type="checkbox"/> Bentonite <input checked="" type="checkbox"/> Concrete Depth: From 0 ft. to 10 ft.		
				16. Nearest source of possible contamination: N/A ft. _____ Direction _____ Type _____ Well disinfected upon completion? Yes <input checked="" type="checkbox"/> No <input type="checkbox"/>		
				17. Pump: Goulds US Pumps Manufacturer's name Goulds Not installed Model number 12JHC HP 125 Volts _____ Length of drop pipe 260 ft. capacity 1000 g.p.m. Type: <input type="checkbox"/> Submersible <input checked="" type="checkbox"/> Turbine <input type="checkbox"/> Jet <input type="checkbox"/> Reciprocating <input type="checkbox"/> Centrifugal <input type="checkbox"/> Other		
18. Elevation:		19. Remarks:		20. Water well contractor's certification: This well was drilled under my jurisdiction and this report is true to the best of my knowledge and belief. Hunter Wilson Drilling 208 Business name P.O. Box A Garden City, Ks License No. _____ Authorized representative _____ Date 2-26-76		
Topography: <input type="checkbox"/> Hill <input checked="" type="checkbox"/> Slope <input type="checkbox"/> Upland <input type="checkbox"/> Valley						

Forward the white, blue and pink copies to the Department of Health and Environment

Form WWC-5

The
Professionals

MINTER-WILSON DRILLING CO.
INCORPORATED

Installation
and Domestic
Water Systems
Complete Installation
and Repairing

Phone 276-8269 • P.O. Box 493 • GARDEN CITY, KANSAS 67846

Harold White
Kearny County
10-22-75

Location: NE 12
Circle 1 - 300 ft. North of Pivot

0	17	Fine Sand
17	34	Brown Clay
34	187	Med. to Coarse Sand & Gravel
187	199	Brown Sandy Clay
199	291	Fine to Med. Sand & Gravel
291	352	Fine to Med. Sand & Gravel, 10% Clay
352	368	Brown Sandy Clay
368	380	Yellow Clay