USE TYPEWRITER OR BALL POINT PEN-PRESS FIRMLY, PRINT CLEARLY.

WATER WELL RECORD
KSA 82a-1201-1215

Kansas Department of Health and Environment-Division of Environment
(Water well Contractors)
Topeka, Kansas 66620

1. Location of well:	County	Fraction	Section number	Township number	Range number
	KEARNY	SW 1/4 SE 1/4 SE 1/4	12	T 26 S	R 35 E/W

2. Distance and direction from nearest town or city: Across the river bridge at Deerfield ¼ east 13 south 2 east
Street address of well location if in city: ½ north

3. Owner of well: Harold White
R.R. or street: Lakin, Ks 67860
City, state, zip code:

4. Locate with "X" in section below:

Sketch map:

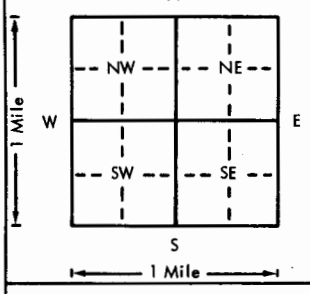

6. Bore hole dia. 26 in. Completion date 5-30-76
Well depth 324 ft.

7. ___ Cable tool ___ Rotary ___ Driven ___ Dug
___ Hollow rod ___ Jetted ___ Bored X Reverse rotary

8. Use: ___ Domestic ___ Public supply ___ Industry
X Irrigation ___ Air conditioning ___ Stock
___ Lawn ___ Oil field water ___ Other

9. Casing: Material steel Height: Above or below mlc
Threaded ___ Welded X Surface 12 in.
RMP ___ PVC ___ Weight 36.87 lbs./ft.
Dia. 16 in. to 325 ft. depth Wall Thickness: inches or
Dia. ___ in. to ___ ft. depth gage No. .219 mlc

5. Type and color of material	From	To

(Use a second sheet if needed)

10. Screen: Manufacturer's name Johnson Division
Type Galv. Dia. 16"
Slot/gauze 100 Length 20'
Set between 220 ft. and 240 ft.
Perf. 180-220 ft. and 240-324 ft.
Gravel pack? yes Size range of material ½" Down

11. Static water level: mo./day/yr.
100 ft. below land surface Date 1-16-76

12. Pumping level below land surfaces: 1150
161 ft. after 3 hrs. pumping ___ g.p.m.
___ ft. after ___ hrs. pumping ___ g.p.m.
Estimated maximum yield 1150 g.p.m.

13. Water sample submitted: mo./day/yr.
___ Yes X No Date

14. Well head completion:
___ Pitless adapter 12 Inches above grade

15. Well grouted? yes
With: ___ Neat cement ___ Bentonite X Concrete
Depth: From 0m ft. to ___ ft. 10

16. Nearest source of possible contamination: N/A
ft. ___ Direction ___ Type ___
Well disinfected upon completion? ___ Yes X No

17. Pump: ___ Not installed
Manufacturer's name Goulds US Pumps
Model number 12JHC HP 100 Volts
Length of drop pipe 160 ft. capacity 1200 g.p.m.
Type: X
___ Submersible ___ Turbine
___ Jet ___ Reciprocating
___ Centrifugal ___ Other

18. Elevation:

Topography:
___ Hill
X Slope
___ Upland
___ Valley

19. Remarks:

RECEIVED
AUG 1976
KANSAS GEOLOGICAL SURVEY
Ground Water Section

20. Water well contractor's certification:
This well was drilled under my jurisdiction and this report is true to the best of my knowledge and belief.
Minter Wilson Drilling 208
Business name License No.
Address P.O. Box A Garden City, Ks
Signed Irene LaDuke Date 8-3-76
Authorized representative

T R E W Sec 1/4 1/4 1/4

Forward the white, blue and pink copies to the Department of Health and Environment

Form WWC-5

MI-1023

The Professionals MINTER-WILSON DRILLING CO. INCORPORATED and Repairing

Phone 276-8269 • P.O. Box 493 • GARDEN CITY, KANSAS 67846

Harold White
Location: ¼ mile south of Pivot 2
Test: 2C

XXX

0	38	Fine sand
38	72	Fine to med. sand & gravel (Loose)
72	86	Brown white clay
86	104	Bro clay stick
104	180	Fine to med. sand & gravel (loose)
180	200	Fine to med. sand (loose)
200	239	Fine to med. sand & gravel (loose)
239	262	Fine to med. sand, gravel (Hard)
262	300	Fine to med. sand (tight)
300	324	Fine to med. sand & gravel (tight)
324	380	Fine sand (Hard)
380		Brown yellow (very Hard)