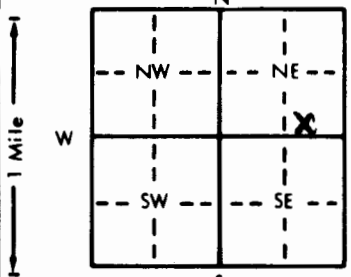


1 LOCATION OF WATER WELL:	Fraction	Section Number	Township Number	Range Number
County: Kearny	SW 1/4 SE 1/4 NE 1/4	14	T 26 S	R 35 E/W

Distance and direction from nearest town or city street address of well if located within city?

12 1/4 miles SE of Lakin, KS--

2 WATER WELL OWNER:	Cheyenne Drilling	#1 Flint Hills
RR#, St. Address, Box # :	W Hwy. 50, Box 916	Board of Agriculture, Division of Water Resources
City, State, ZIP Code :	Garden City, KS 67846	Application Number: Applied for-

3 LOCATE WELL'S LOCATION WITH AN "X" IN SECTION BOX:	4 DEPTH OF COMPLETED WELL: 320 ft. ELEVATION:
	Depth(s) Groundwater Encountered 1. 145 ft. 2. ft. 3. ft.
	WELL'S STATIC WATER LEVEL 145 ft. below land surface measured on mo/day/yr 03-29-92
	Pump test data: Well water was 200 ft. after 1 hours pumping 100 gpm
	Est. Yield 100 gpm: Well water was ft. after hours pumping gpm
	Bore Hole Diameter 9 1/2 in. to 320 ft., and in. to ft.
	WELL WATER TO BE USED AS:
	1 Domestic 3 Feedlot 6 Oil field water supply 9 Dewatering 12 Other (Specify below)
	2 Irrigation 4 Industrial 7 Lawn and garden only 10 Monitoring well
	Was a chemical/bacteriological sample submitted to Department? Yes.....No.....X.....; If yes, mo/day/yr sample was submitted
	Water Well Disinfected? Yes X No

5 TYPE OF BLANK CASING USED:	5 Wrought iron	8 Concrete tile	CASING JOINTS: Glued X Clamped
1 Steel	3 RMP (SR)	6 Asbestos-Cement	9 Other (specify below)
2 PVC	4 ABS	7 Fiberglass	Welded
Blank casing diameter 5 in. to 320 ft., Dia			Threaded
Casing height above land surface 24 in., weight			lbs./ft. Wall thickness or gauge No. 032
TYPE OF SCREEN OR PERFORATION MATERIAL:			
1 Steel	3 Stainless steel	5 Fiberglass	8 RMP (SR)
2 Brass	4 Galvanized steel	6 Concrete tile	9 ABS
SCREEN OR PERFORATION OPENINGS ARE:			
1 Continuous slot	3 Mill slot	5 Gauzed wrapped	8 Saw cut
2 Louvered shutter	4 Key punched	6 Wire wrapped	9 Drilled holes
SCREEN-PERFORATED INTERVALS:			
From 240 ft. to 320 ft., From			
GRAVEL PACK INTERVALS:			
From 120 ft. to 320 ft., From			

6 GROUT MATERIAL:	1 Neat cement	2 Cement grout	3 Bentonite	4 Other Hole Plug
Grout Intervals: From 1 ft. to 20 ft., From				
What is the nearest source of possible contamination:				
1 Septic tank	4 Lateral lines	7 Pit privy	10 Livestock pens	14 Abandoned water well
2 Sewer lines	5 Cess pool	8 Sewage lagoon	11 Fuel storage	15 Oil well/Gas well
3 Watertight sewer lines	6 Seepage pit	9 Feedyard	12 Fertilizer storage	16 Other (specify below)
Direction from well? East				
How many feet? 180				

FROM	TO	LITHOLOGIC LOG	FROM	TO	PLUGGING INTERVALS
0	75	Sand			
75	95	Gravel			
95	124	Clay			
124	240	Sand and Gravel			
240	250	Clay			
250	280	Sand			
280	290	Clay			
290	320	Sand			

7 CONTRACTOR'S OR LANDOWNER'S CERTIFICATION: This water well was (1) constructed, (2) reconstructed, or (3) plugged under my jurisdiction and was completed on (mo/day/year) 03-29-92 and this record is true to the best of my knowledge and belief. Kansas Water Well Contractor's License No. KWWCL-430 This Water Well Record was completed on (mo/day/yr) 03-29-92 under the business name of Howard Drlg.Co. Box 806 Beaver, OK 73932 by (signature)
--

INSTRUCTIONS: Use typewriter or ball point pen. PLEASE PRESS FIRMLY and PRINT clearly. Please fill in blanks, underline or circle the correct answers. Send top three copies to Kansas Department of Health and Environment, Bureau of Water, Topeka, Kansas 66620-0001. Telephone: 913-296-5545. Send one to WATER WELL OWNER and retain one for your records.