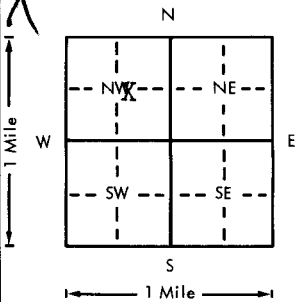


#2 well

USE TYPEWRITER OR BALL
POINT PEN-PRESS FIRMLY,
PRINT CLEARLY.

WATER WELL RECORD
KSA 82a-1201-1215

Kansas Department of Health and
Environment-Division of Environment
(Water well Contractors)
Topeka, Kansas 66620

1. Location of well:		County Kearny	Fraction NW 1/4 SE 1/4 NW 1/4	Section number 26	Township number T 26 S	Range number R 35 W E/W
2. Distance and direction from nearest town or city: 8 South of Lakin, Ks. Street address of well location if in city:				3. Owner of well: Potter Ranch c/o J. R. Kleysteuber R.R. or street: City, state, zip code: Copeland, Kansas 67837		
4. Locate with "X" in section below:		Sketch map:		6. Bore hole dia. 9 7/8 in. Completion date _____ Well depth 199 ft. 6-23-78		
				7. Cable tool <input checked="" type="checkbox"/> Rotary <input type="checkbox"/> Driven <input type="checkbox"/> Dug <input type="checkbox"/> Hollow rod <input type="checkbox"/> Jetted <input type="checkbox"/> Bored <input type="checkbox"/> Reverse rotary		
				8. Use: <input type="checkbox"/> Domestic <input type="checkbox"/> Public supply <input type="checkbox"/> Industry <input type="checkbox"/> Irrigation <input type="checkbox"/> Air conditioning <input checked="" type="checkbox"/> Stock <input type="checkbox"/> Lawn <input type="checkbox"/> Oil field water <input type="checkbox"/> Other		
5. Type and color of material		From	To	9. Casing: Material PVC Height: Above or below _____ Threaded <input type="checkbox"/> Welded <input checked="" type="checkbox"/> Surface 24 in. RMP <input type="checkbox"/> PVC <input checked="" type="checkbox"/> Weight 2.8 lbs./ft. Dia. 5 in. to 199 ft. depth Wall Thickness: inches or _____ Dia. _____ in. to _____ ft. depth Gauge No. 265		
Fine sand with some clay		0	60	10. Screen: Manufacturer's name Pumpco Type PVC Dia. 5" Slot 1/8" Length 60' Set between 139 ft. and 199 ft. Gravel pack? Yes Size range of material 1/64-5/32		
Med. to lar. sand & gravel		60	130	11. Static water level: _____ mo./day/yr. 125 ft. below land surface Date 6/22/78		
Med. to lar. sand with clay		130	200	12. Pumping level below land surfaces: _____ ft. after _____ hrs. pumping _____ g.p.m. _____ ft. after _____ hrs. pumping 50 g.p.m. Estimated maximum yield _____ g.p.m.		
Clay		200	204	13. Water sample submitted: _____ mo./day/yr. Yes <input checked="" type="checkbox"/> No <input type="checkbox"/> Date _____		
				14. Well head completion: Pitless adapter 24 Inches above grade		
				15. Well grouted? Yes With: <input checked="" type="checkbox"/> Neat cement <input type="checkbox"/> Bentonite <input type="checkbox"/> Concrete Depth: From 0 ft. to 10 ft.		
				16. Nearest source of possible contamination: NONE ft. _____ Direction _____ Type _____ Well disinfected upon completion? <input checked="" type="checkbox"/> Yes <input type="checkbox"/> No		
				17. Pump: _____ Not installed Manufacturer's name Erected His Mill Model number _____ HP _____ Volts _____ Length of drop pipe 168 ft. capacity 3 g.p.m. Type: <input type="checkbox"/> Submersible <input type="checkbox"/> Turbine <input type="checkbox"/> Jet <input type="checkbox"/> Reciprocating <input type="checkbox"/> Centrifugal Windmill <input checked="" type="checkbox"/> Other		
18. Elevation:		19. Remarks:		20. Water well contractor's certification: This well was drilled under my jurisdiction and this report is true to the best of my knowledge and belief. Friesen Windmill 252 Business name License No. Address Meade, Kansas 67864 Signed Jeff Friesen Date 2-24-78 Authorized representative		
Topography: <input type="checkbox"/> Hill <input type="checkbox"/> Slope <input type="checkbox"/> Upland <input checked="" type="checkbox"/> Valley						

Forward the white, blue and pink copies to the Department of Health and Environment

Form WWC-5